MAP OF SURVEY

OF

EXISTING MONUMENTS ON PAPAGO DRIVE
BETWEEN McANDREWS ROAD AND LONE PINE ROAD
LOCATED IN THE
NORTHEAST QUARTER OF SECTION 20, T.37S., R.1W., W.M.
CITY OF MEDFORD, JACKSON COUNTY, OREGON

SURVEY BY:
CITY OF MEDFORD
SURVEY DIVISION
411 WEST EIGHTH STREET
MEDFORD. OREGON 97501

JANUARY 1993

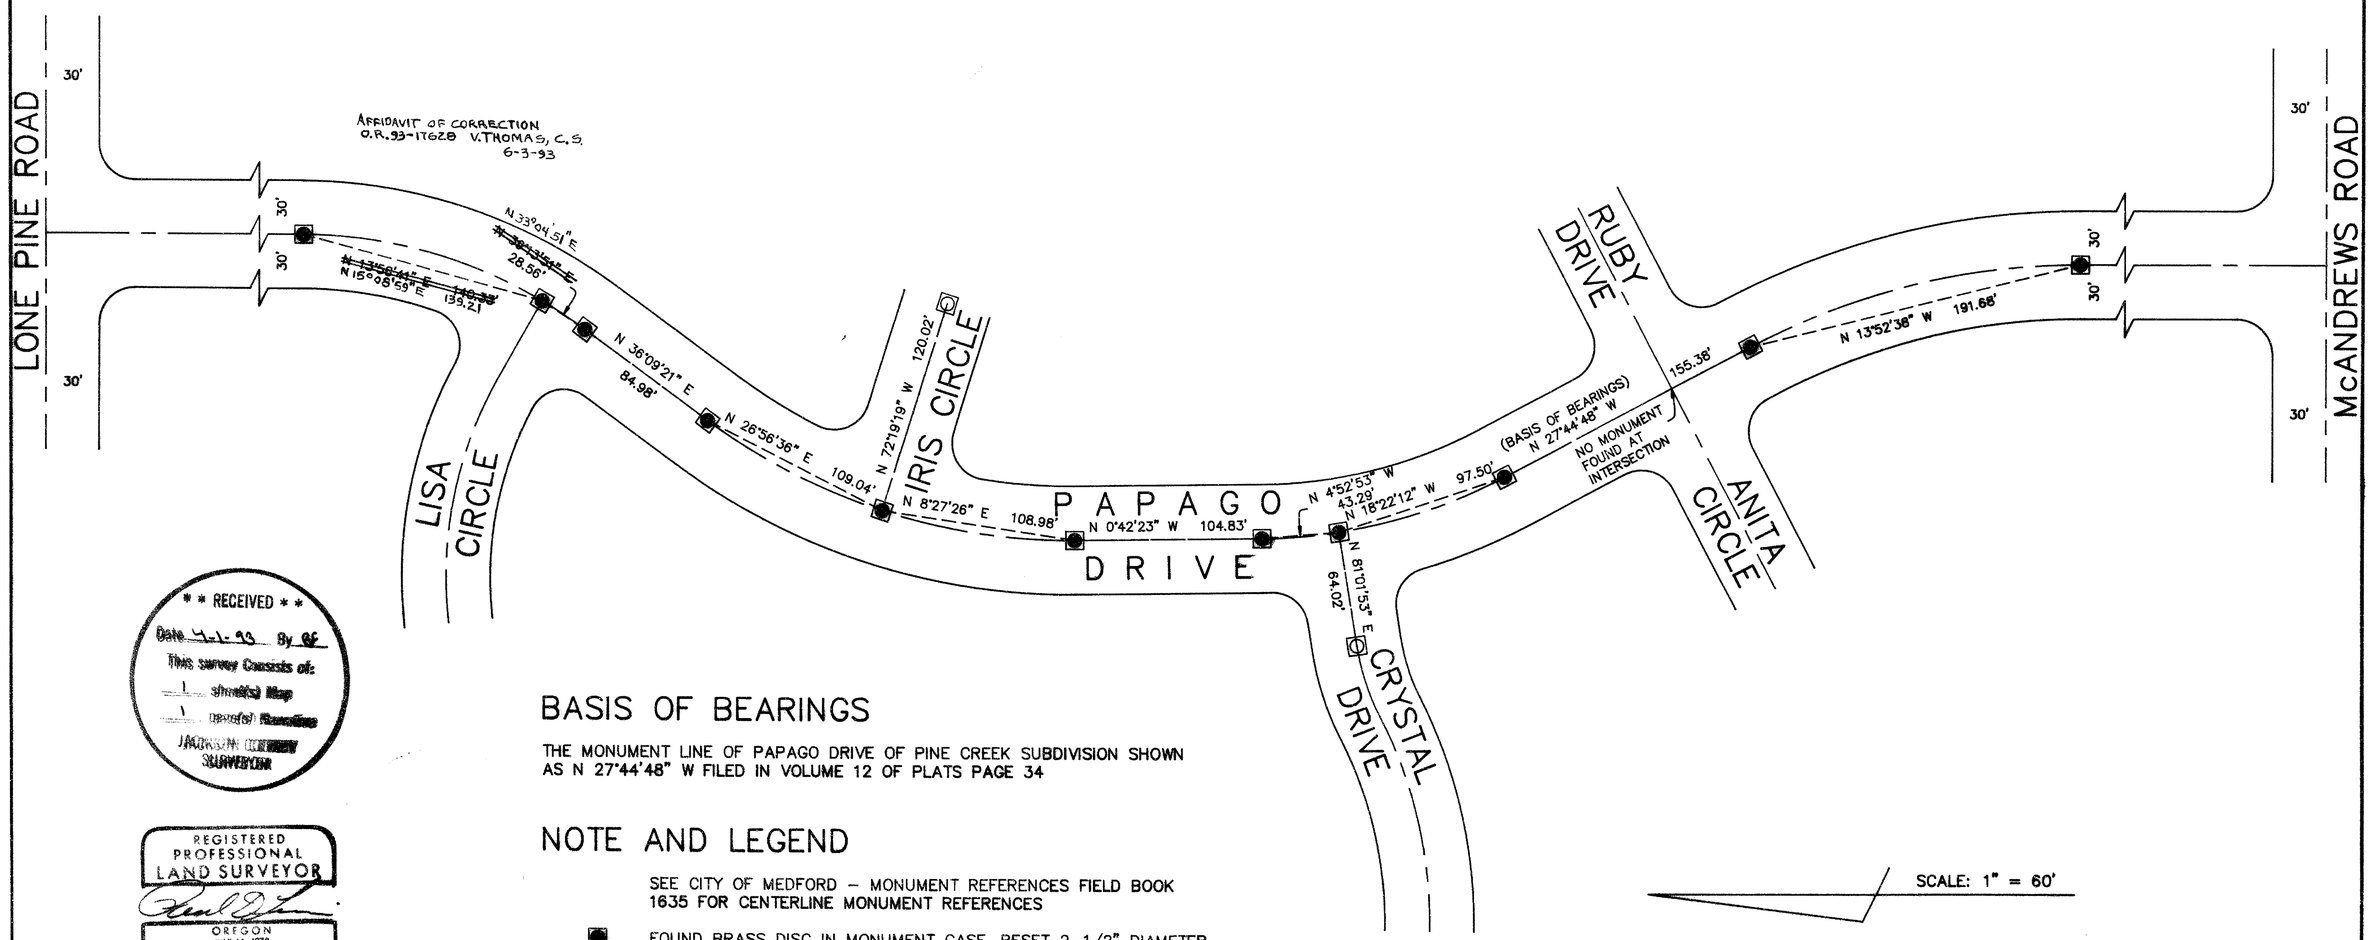

** RECEIVED **
Date 4-1-93 By RF
This survey Consists of:
1 sheet(s) Map
1 page(s) Narrative
JACKSON COUNTY SURVEYOR

REGISTERED PROFESSIONAL LAND SURVEYOR
OREGON
JULY 14, 1978
PAUL D. LEWIS
1644
EXPIRES 12-31-94

BASIS OF BEARINGS

THE MONUMENT LINE OF PAPAGO DRIVE OF PINE CREEK SUBDIVISION SHOWN AS N 27°44'48" W FILED IN VOLUME 12 OF PLATS PAGE 34

NOTE AND LEGEND

SEE CITY OF MEDFORD – MONUMENT REFERENCES FIELD BOOK 1635 FOR CENTERLINE MONUMENT REFERENCES

■ FOUND BRASS DISC IN MONUMENT CASE, RESET 2-1/2" DIAMETER BRASS DISC STAMPED "1644" IN CONCRETE, FLUSH WITH PAVING

◎ FOUND BRASS DISC IN MONUMENT CASE

SCALE: 1" = 60'

T37-1W-20A

SURVEY NO. 13436

SURVEY NARRATIVE TO COMPLY WITH O.R.S. 209.250

SURVEY FOR: CITY OF MEDFORD
411 W. 8TH STREET
MEDFORD, OR 97501

LOCATION: NORTHEAST QUARTER OF SECTION 20, TOWNSHIP 37 SOUTH, RANGE 1 WEST, WILLAMETTE MERIDIAN, CITY OF MEDFORD, JACKSON COUNTY, OREGON.

PURPOSE: TO PERPETUATE EXISTING CENTERLINE MONUMENTATION ALONG PAPAGO DRIVE FROM MCANDREWS ROAD TO LONE PINE ROAD.

PROCEDURE: EXISTING MONUMENTS WERE RECOVERED AND REFERENCED AND NEW MONUMENTS SET FLUSH WITH PAVEMENT AS SHOWN ON MAP.

SURVEY BY: CITY OF MEDFORD
SURVEY DIVISION
411 W. 8TH STREET
MEDFORD, OR 97501

DATE: JANUARY, 1993

* * RECEIVED * *
Date 4-1-93 By BF
This survey Consists of:
1 sheet(s) Map
1 page(s) Narrative
JACKSON COUNTY SURVEYOR

REGISTERED PROFESSIONAL LAND SURVEYOR
OREGON
JULY 14, 1978
PAUL D. LEWIS
1644
EXPIRES 12-31-94

93-17628

CITY OF MEDFORD
SURVEY DIVISION
411 W. 8TH STREET
MEDFORD, OREGON 97501

5.00
Surv. file 6.00
9:03

AFFIDAVIT OF CORRECTION
pursuant to O.R.S. 209.255

13436

I, Paul D. Lewis, Registered Professional Land Surveyor of the State of Oregon, No. 1644, do hereby state that I have discovered two drafting errors in the "MAP OF SURVEY of Existing Monuments on Papago Drive Between McAndrews Road and Lone Pine Road", filed in the Office of Jackson County Surveyor as: County Surveyor File No. 13436.

Paul D. Lewis, L.S. 1644

REGISTERED
PROFESSIONAL
LAND SURVEYOR
OREGON
JULY 14, 1978
PAUL D. LEWIS
1644
EXPIRES 12-31-94

STATE OF OREGON)
County of Jackson) ss.

May 19 A.D. 1993

Personally appeared the above named Paul D. Lewis, a Registered Professional Land Surveyor, and acknowledged the foregoing instrument to be his voluntary act and deed.

Before me:

OFFICIAL SEAL
JANA M. SMITH
NOTARY PUBLIC - OREGON
COMMISSION NO. 015271
MY COMMISSION EXPIRES MAY 26, 1996

Jackson County, Oregon
Recorded
OFFICIAL RECORDS

9:03 JUN 01 1993 A M.
KATHLEEN S. BECKETT
CLERK and RECORDER
By Jo Ramsey Deputy

The errors and corrections are:

1.) Chord bearing and distance

Reads: "N 13° 58' 41" E 140.33' "

Change To: "N 15° 08' 59" E 139.21' "

2.) Chord Bearing

Reads: "N 39° 13' 51" E"

Change To: "N 33° 04' 51" E"

The Jackson County Surveyor hereby certifies that this Affidavit of Correction has been examined and approved for recording.

Jackson County Surveyor