

# MAP OF SURVEY

13465

**LOCATED** in Lot 2, Block 1, of NICKELL ADDITION to the City of Medford in the SW 1/4 of Section 25, T. 37 S., R. 2 W., W.M., Jackson County, Oregon.

February 5, 1993

**SURVEYED FOR:** Ken Gibson  
4070 Willow Springs Rd.  
Central Point, Oregon

**SURVEYED BY:** Edwards Surveying and Land Planning, Inc.  
823 West 8th Street  
Medford, Oregon 97501  
Phone (503) 776-2313

REGISTERED  
PROFESSIONAL  
LAND SURVEYOR

*David A. Edwards*

OREGON  
JULY 26, 1968  
DAVID A. EDWARDS  
2339

Expires 12/31/93

## LEGEND


- Indicates 5/8" diam. steel pin w/cap fd. per R.S.N. 13439
  - Indicates 5/8" x 30" steel pin w/red plastic cap mkd. "D.A. EDWARDS-LS 2339" set
- J.C.S. = Jackson County Surveyor  
R.S.N. = Recorded Survey Number  
SCALE: 1" = 100'  
BASIS OF BEARINGS: Existing control per R.S.N. 13439

**\*\* RECEIVED \*\***

Date 4-14-93 By DE

This survey consists of:  
1 sheet(s) Map  
1 page(s) Narrative

JACKSON COUNTY  
SURVEYOR

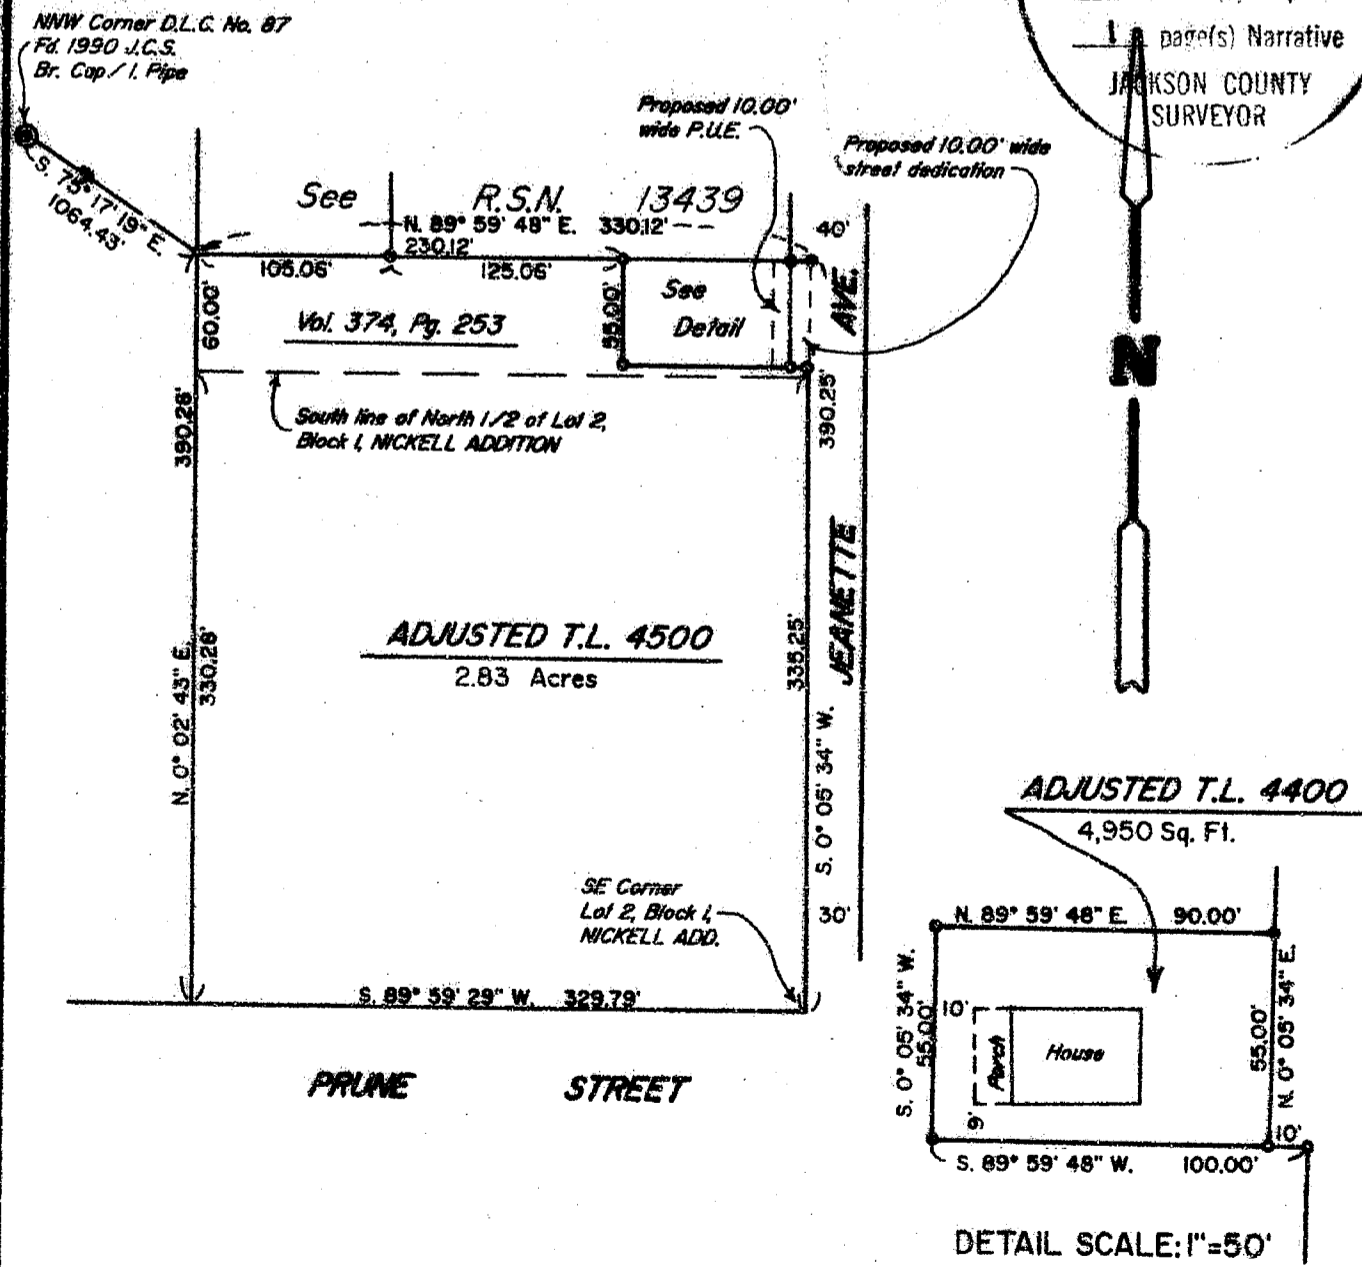

13465





















