


Survey For  
 DAVID B. LOWRY  
 Located in Lot No. 3,  
 ROYAL ORCHARD  
 Sec. 22, T. 38 S., R. 1 W., W.M.  
 By: Mark E. Boyden  
 January 1960

SW. Cor. D.L.C. 58  
 Fd. 1-1/2" G.I. pipe

S 0° 07' 10" W  
 47.90'

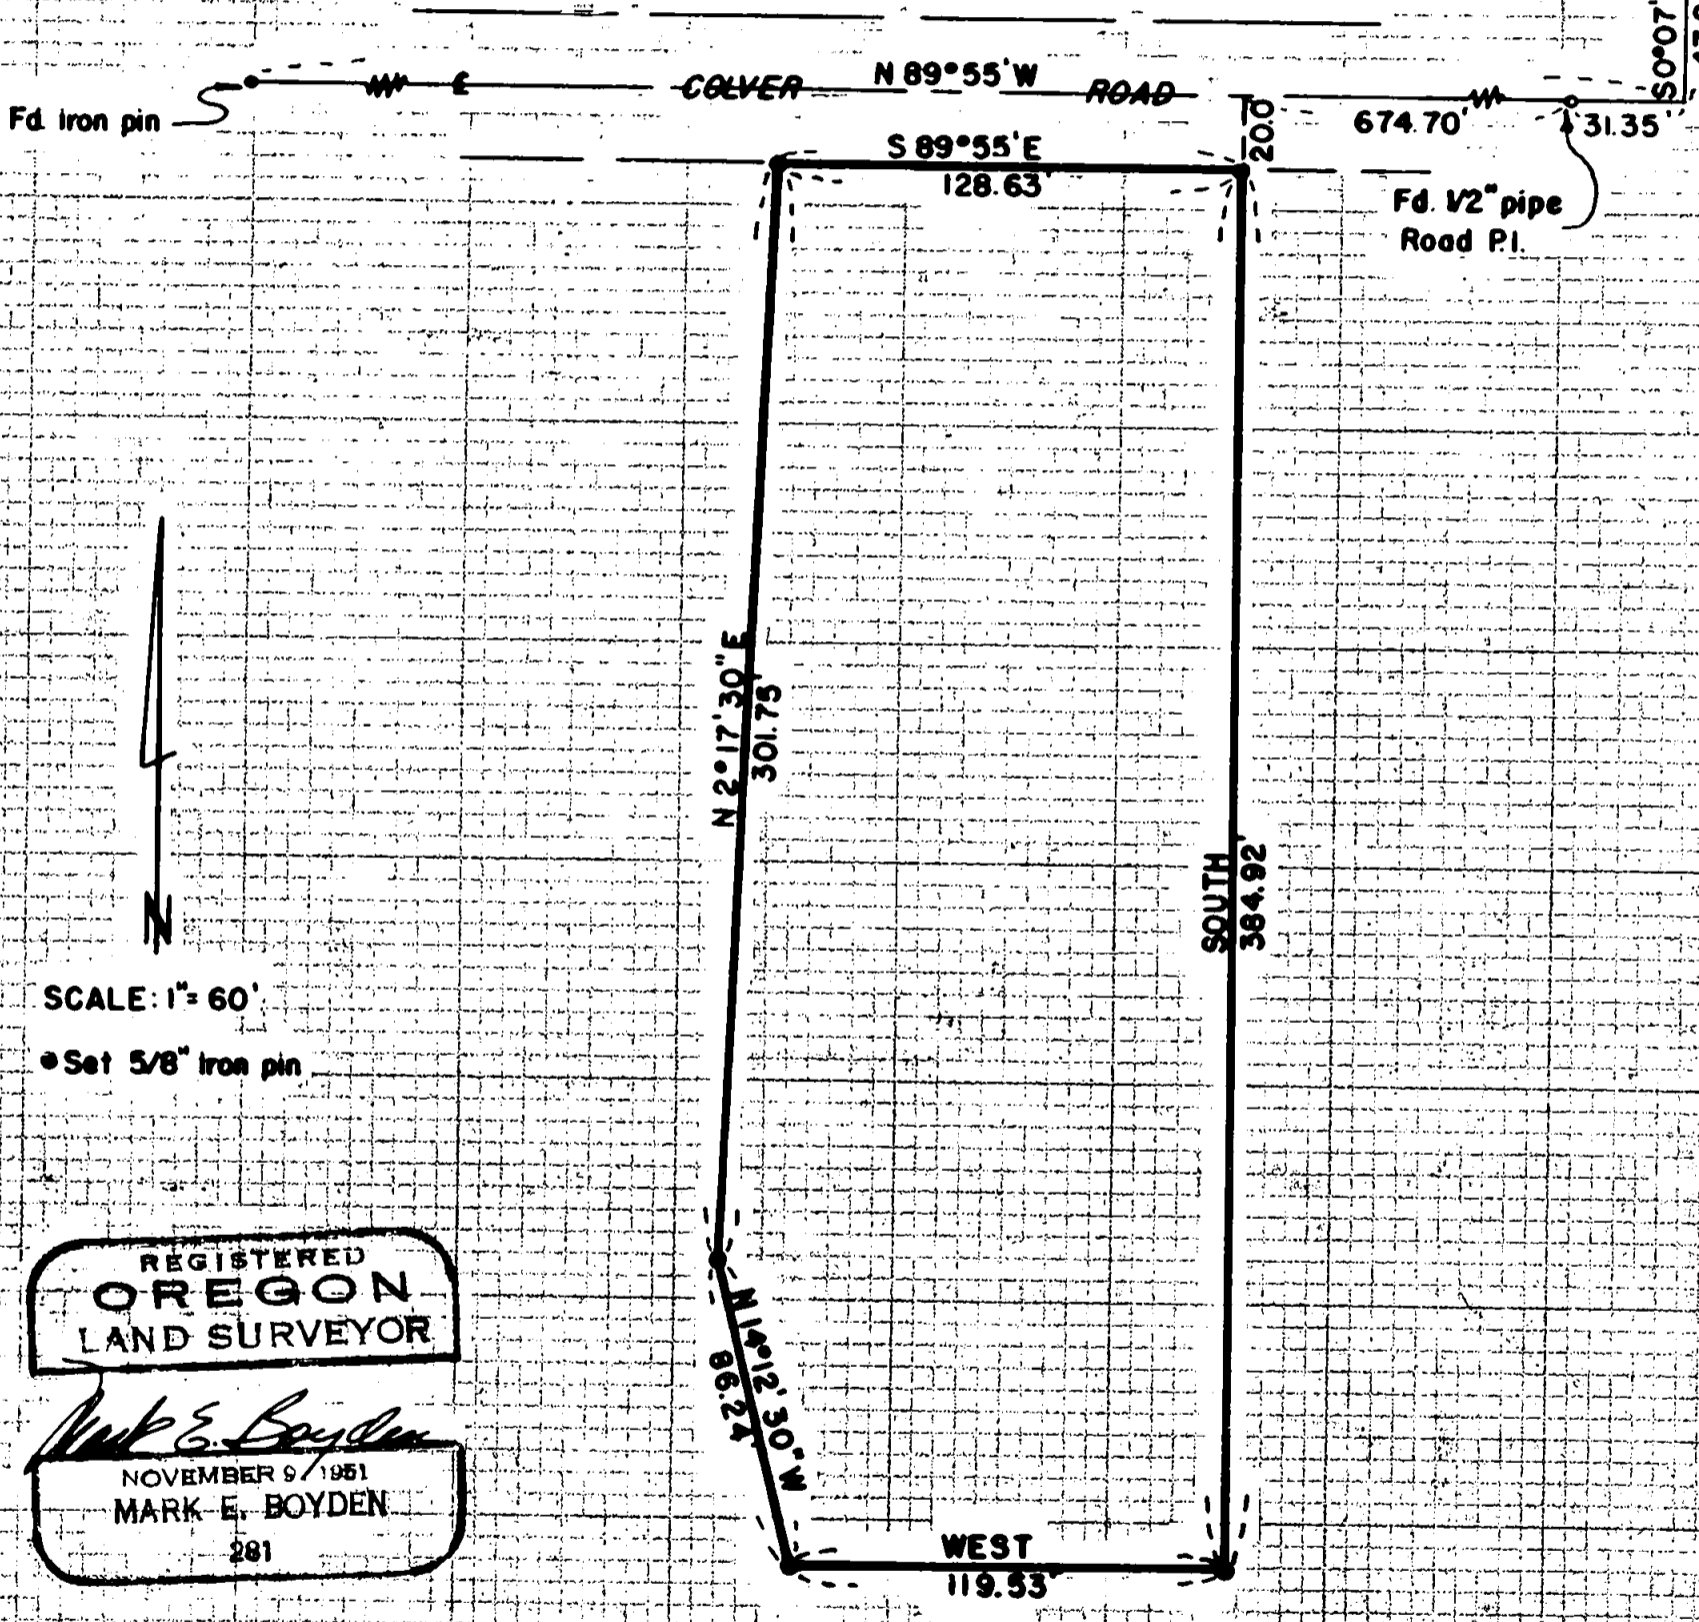

SCALE: 1" = 60'

• Set 5/8" iron pin

REGISTERED  
 OREGON  
 LAND SURVEYOR

*Mark E. Boyden*  
 NOVEMBER 9 / 1951  
 MARK E. BOYDEN  
 281



Survey Narrative to Comply with Paragraph 209.250,  
Oregon Revised Statutes

FOR: David B. Lowry

PURPOSE: To monument and describe a parcel within the overall Suncrest Orchards, Inc. property described in Volume 480, Page 473 of the Deed Records of Jackson County, Oregon, being located in Lot No. 3 of ROYAL ORCHARDS, Donation Land Claim Nos. 61 and 62, Section 22, Township 38 South, Range 1 West.

PROCEDURE: Found the controls for Colver Road as established by this office on Recorded Survey No. 661. From said information, monumented the agreed-upon parcel of land with 5/8" iron pins as shown.

January 1960

REGISTERED  
OREGON  
LAND SURVEYOR  
*Mark E. Boyden*  
NOVEMBER 9 1951  
MARK E. BOYDEN  
281

RECEIVED  
JACKSON  
JAN 25 1960  
COUNTY  
ENGINEER-SURVEYOR