


LEGEND:

- O.R. OFFICIAL RECORDS, JACKSON COUNTY, OREGON
- SET 5/8" x 30" IRON PIN WITH A PLASTIC CAP MARKED "MARQUESS & ASSOC" UNLESS OTHERWISE NOTED
- R= RECORD BEARINGS AND/OR DISTANCES
- POWER POLE

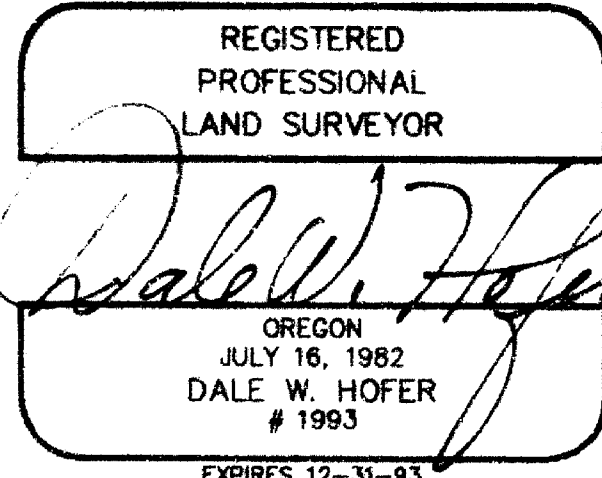

**** RECEIVED ****
 Date 7-16-93 By SK
 This survey consists of:
 + sheet(s) Map
 - page(s) Narrative
 JACKSON COUNTY SURVEYOR

SURVEY FOR:

LARRY BIGHAM
 7432 S. MAGIC VIEW CIRCLE
 SALT LAKE CITY, UTAH 84121


SURVEYOR:

MARQUESS AND ASSOCIATES INC.
 1120 EAST JACKSON STREET
 MEDFORD, OREGON 97504
 TELE: 772-7115

BASIS OF BEARINGS:
 THE EAST WEST 1/4 SECTION LINE
 SECTION 27 FROM RS 11064

MAP OF SURVEY

LOCATED IN
 NORTHEAST 1/4 SECTION 27
 TOWNSHIP 35 SOUTH, RANGE 2 WEST
 WILLAMETTE MERIDIAN, JACKSON COUNTY, OREGON

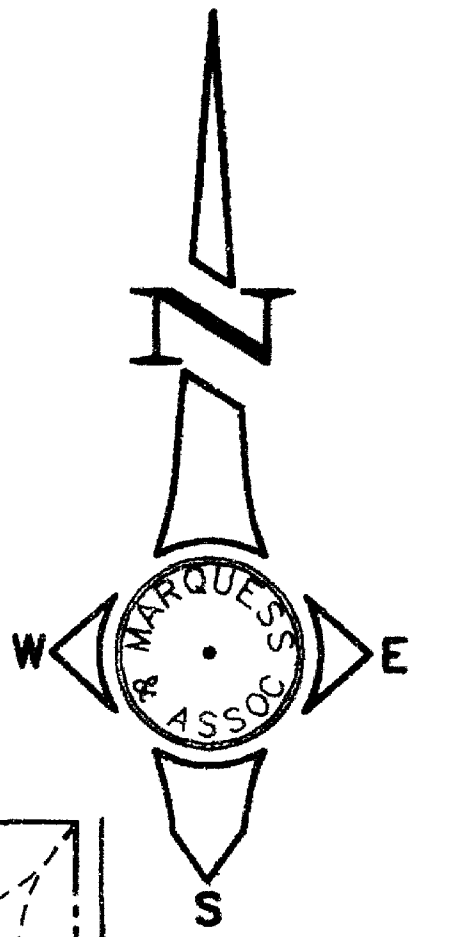

SCALE: 1"=60'
 JULY 15, 1993



SURVEY NO. 13576

SURVEY NARRATIVE TO COMPLY WITH O.R.S. 209.250(2)

SURVEY OF BOUNDARY LINE FOR:

LARRY BIGHAM

LOCATION:

IN THE NE 1/4 OF S27, TOWNSHIP 35 SOUTH, RANGE 2 WEST, WILLAMETTE
MERIDIAN, JACKSONVILLE, JACKSON COUNTY, OREGON.

PURPOSE:

TO DEFINE THE SOUTH BOUNDARY OF PARCELS OF LAND DESCRIBED IN JACKSON
COUNTY DEED RECORDS #74-16583, V582P80, AND V582P82.

PROCEDURE:

FOUND EXISTING GOVERNMENT MONUMENTS AT THE EAST AND WEST QUARTER CORNERS.
TRAVERSED BETWEEN THESE MONUMENTS WITH LEITZ SET 4 EDM. SHOWED LOT LINES
PER RECORD DEEDS. SET THREE IRON RODS ON LINE APPROXIMATELY 5 FEET INSIDE
OF PROBABLE LOT CORNERS.

DATE: JULY 15, 1993

DALE W. HOFER, LS 1993
MARQUESS & ASSOCIATES, INC.
1120 EAST JACKSON STREET
P. O. BOX 490
MEDFORD, OREGON 97501
PHONE: 503-772-7115

REGISTERED
PROFESSIONAL
LAND SURVEYOR

Dale W. Hofer
OREGON
JULY 16, 1982
DALE W. HOFER
#1993

Exp 12-31-95

**** RECEIVED ****
Date 7-16-93 By SK
This survey Consists of:
1 sheet(s) Map
1 page(s) Narrative
JACKSON COUNTY
SURVEYOR

REF. T3⁵/S R2W S27 TL500, 600, AND 700