


SURVEY IN SEC. 18 T. 38S. R. 1W. W.M.
 FOR
 I. THOMAS
 60-2

BY EDWARD MC GINTY
 MEDFORD OREGON

SCALE 1"=200'
 • = 1/2 I.PIN
 O = 1" PIPE FD.

WEST 1/4 COR.
 SEC. 18

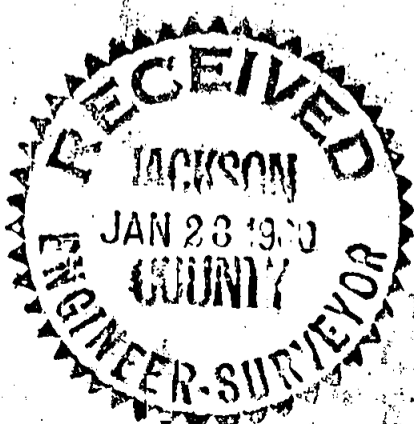

REGISTERED
 OREGON
 LAND SURVEYOR

Edward A. McGinty

JULY 16, 1955
 EDWARD A. MCGINTY
 301

1359

1359

Survey No. _____

Survey Narrative to comply with O.R.S. 209-205 and O.R.S. 209-120

Survey for: I Thomas

Survey by: Edward A. McGinty, L.S. 1/28/60

BASIS OF BEARING: Solar Observation.

PRECEDENCE OF SURVEY:

Found the west one quarter corner of section 18 (see re-estab. notes) Cut out parcel of land as desired by client, using boundaries on the east and west of said tract, and the proposed Talent Irrigation Ditch on the north based on their present alignment.

County road located from instructions by the County engineers office, using the existing fence line and the center line of the existing road on the westerly side of this tract and produced said road easterly.

REGISTERED
OREGON
LAND SURVEYOR

Edward A. McGinty

JULY 19, 1953
EDWARD A. MCGINTY
301

