

13628

SURVEY NARRATIVE TO COMPLY WITH PARAGRAPH 209.250
OREGON REVISED STATUTES

Survey for: Frank McClelland & F. W. Fogelquist
22 Dunlap Road & 44 Dunlap Road
Jacksonville, OR 97530 Jacksonville, OR 97530


Survey by: Charles H. Hurst
765 Sunrise Ave.
Medford, OR 97504

RECEIVED **
Date 8-25-93 By CH
This survey Consists of:
1 sheet(s) Map
0 page(s) Narrative
JACKSON COUNTY
SURVEYOR

Purpose: Lot line adjustment as shown hereon.

Procedure: The adjusted line was monumented from a point on the east line of Survey No. 8206 to a point computed to be on the south line of tract per O.R. 80-07621, the same being on the north line of tract per O.R. 80-07622, and the center line of an existing driveway was located, although not monumented, all in accordance with instructions from the clients.

SURVEY SITUATE IN THE NW/4 OF
SEC. 33, T. 38 S., R. 3 W., W.M., J.C.O.

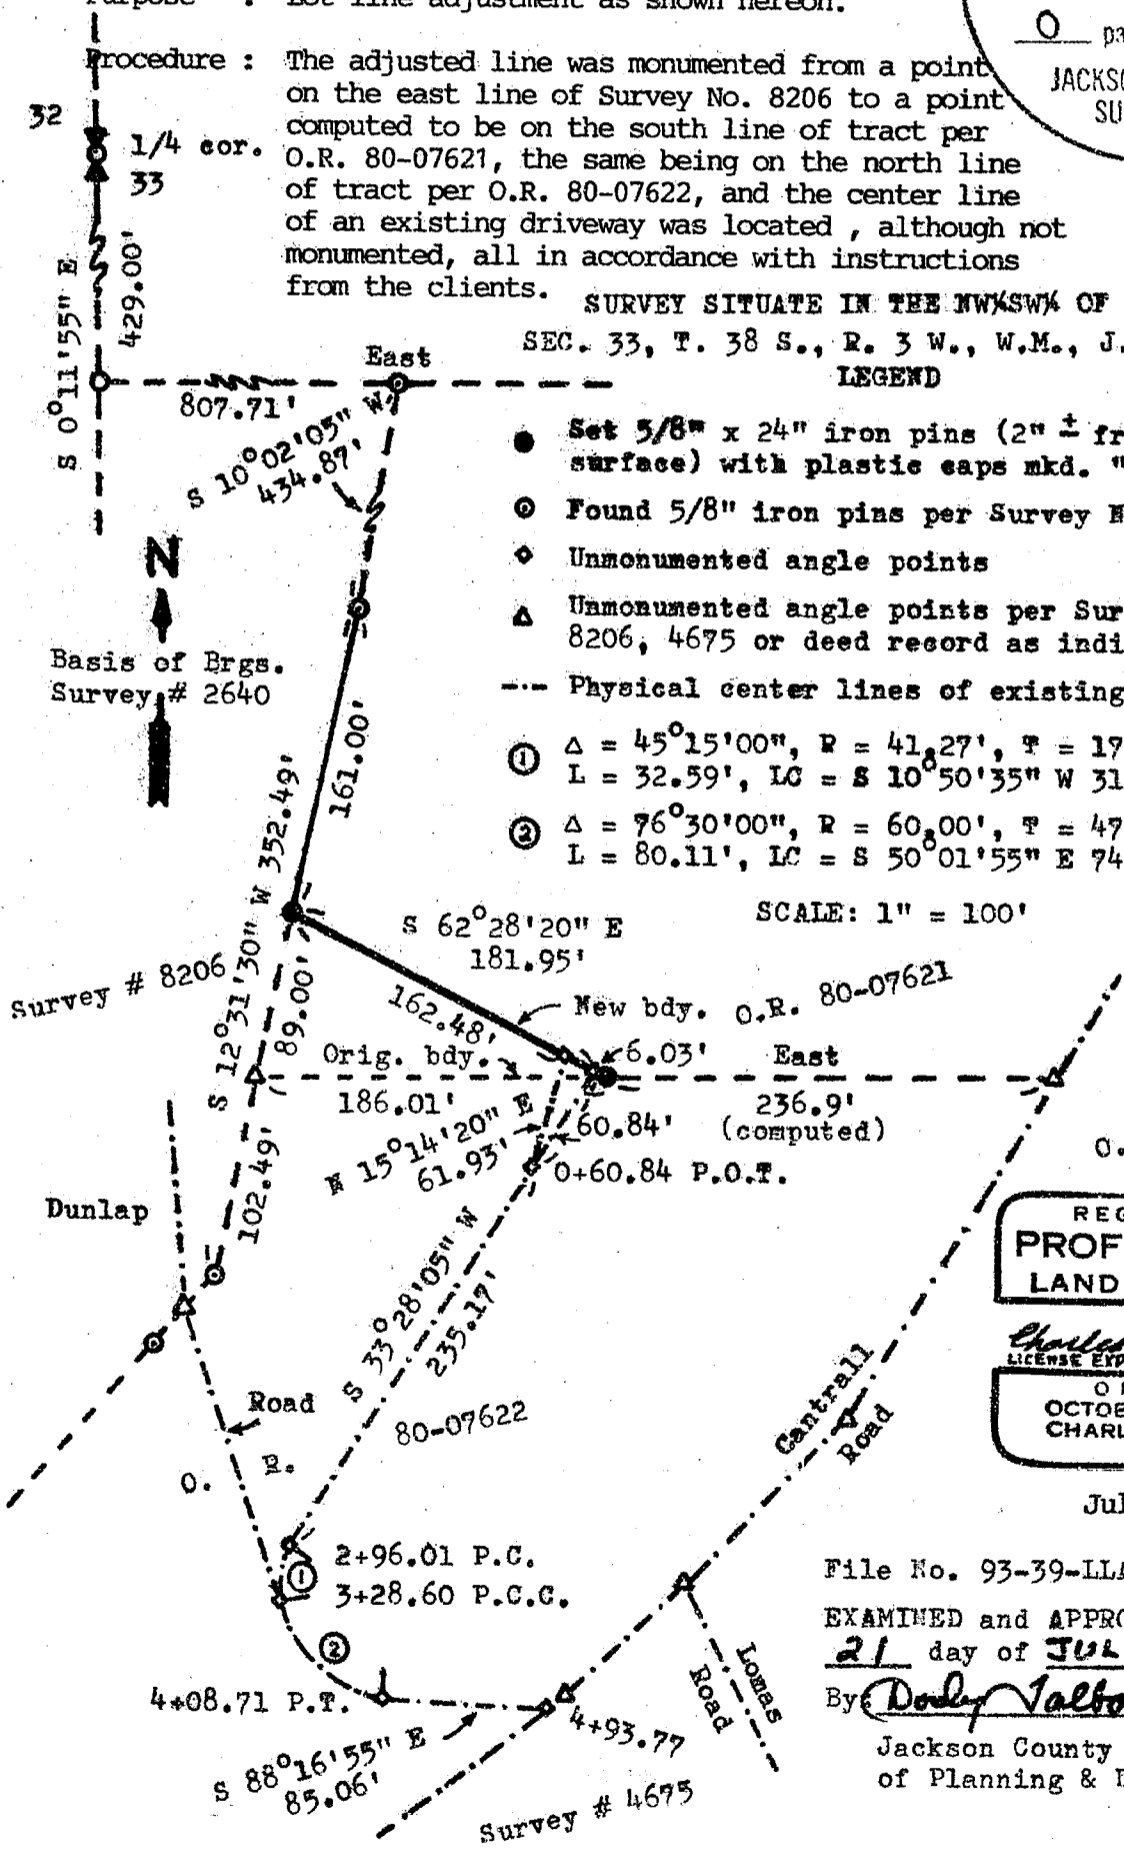

- LEGEND
- Set 5/8" x 24" iron pins (2" ± from ground surface) with plastic caps mkd. "HURST LS 483"
 - Found 5/8" iron pins per Survey No. 8206
 - ◇ Unmonumented angle points
 - △ Unmonumented angle points per Surveys No. 8206, 4675 or deed record as indicated
 - Physical center lines of existing roads
- ① Δ = 45°15'00", R = 41.27', T = 17.20'
L = 32.59', LC = S 10°50'35" W 31.75'
- ② Δ = 76°30'00", R = 60.00', T = 47.30'
L = 80.11', LC = S 50°01'55" E 74.29'

SCALE: 1" = 100'

REGISTERED
PROFESSIONAL
LAND SURVEYOR
Charles H. Hurst
LICENSE EXPIRES 12-31-95
OREGON
OCTOBER 30, 1959
CHARLES H. HURST
483

July 20, 1993

File No. 93-39-LLA
EXAMINED and APPROVED this
21 day of JULY 1993.
By Dorly Talbot

Jackson County Department
of Planning & Development

13628