

Survey No. 1363

Paul Rynning
County Surveyor
Jackson County
Jan. 31, 1960

Township 36 South, Range 3 East, Section 19, W.M.

SUBJECT: To perpetuate the East 1/16 ctr. of Sec. 19 or approx.
East 1/16 ctr. of Sec. 19.

Found a 1 inch iron pipe with a U.S. Gov't. standard bronze disc., marked E-1/16 c., Sec. 19, set in 1956. Two B T's found, scribe on tree to the southeast still visible, but burn't badly, tree to the northwest, scribe burned away. The two trees are both badly damaged by logging and burning operations. Calls to said trees furnished by O & C of BLM were as follows

Yew 15 ins. dia., bears N.38°W., 47 lks.



Yew 12 ins. diam, bears S.43°E., 53 lks.

This corner has not been entered in the approved field notes, so as to leave some doubt as to its true location and has not been officially approved by either the BLM or myself.

To perpetuate its location for future reference for Ross Lumber Co., at the request of C & C of BLM, I made two new bearings, from which

A cedar, 10 ins. diam., bears N.47°E., 166.9 ft.
scribed 301 B T.

A Yew, 12 ins. diam., bears S.40°E., 59.9 ft.
scribed 301 B T.

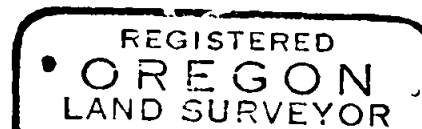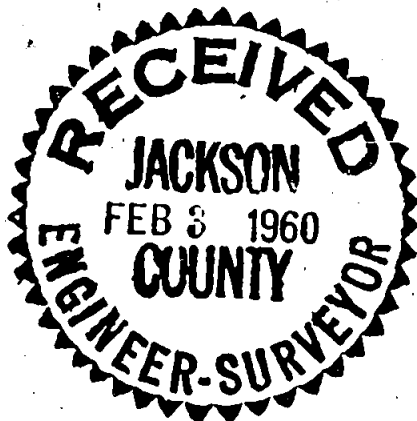

Edward A. McGinty
JULY 16, 1953
EDWARD A. MCGINTY
301