

N1/2 S24 T35S R4W W.M.




SURVEY FOR

MEDFORD CORPORATION
 PO BOX 550
 MEDFORD, OREGON
 97501

SURVEY BY

ARTHUR R. RAMBO
 735 VISTA PARK DRIVE
 EAGLE POINT, OREGON
 97524

(GR-2 N89° 45'W 79.36 CH)
 (GR-1 20.00 CH 20.00 CH N89° 20'W 40.00 CH)
 (PS-1 S89° 20'00"E 5282.62)
 (PS-2 1320.89 N89° 20'W 1320.89)

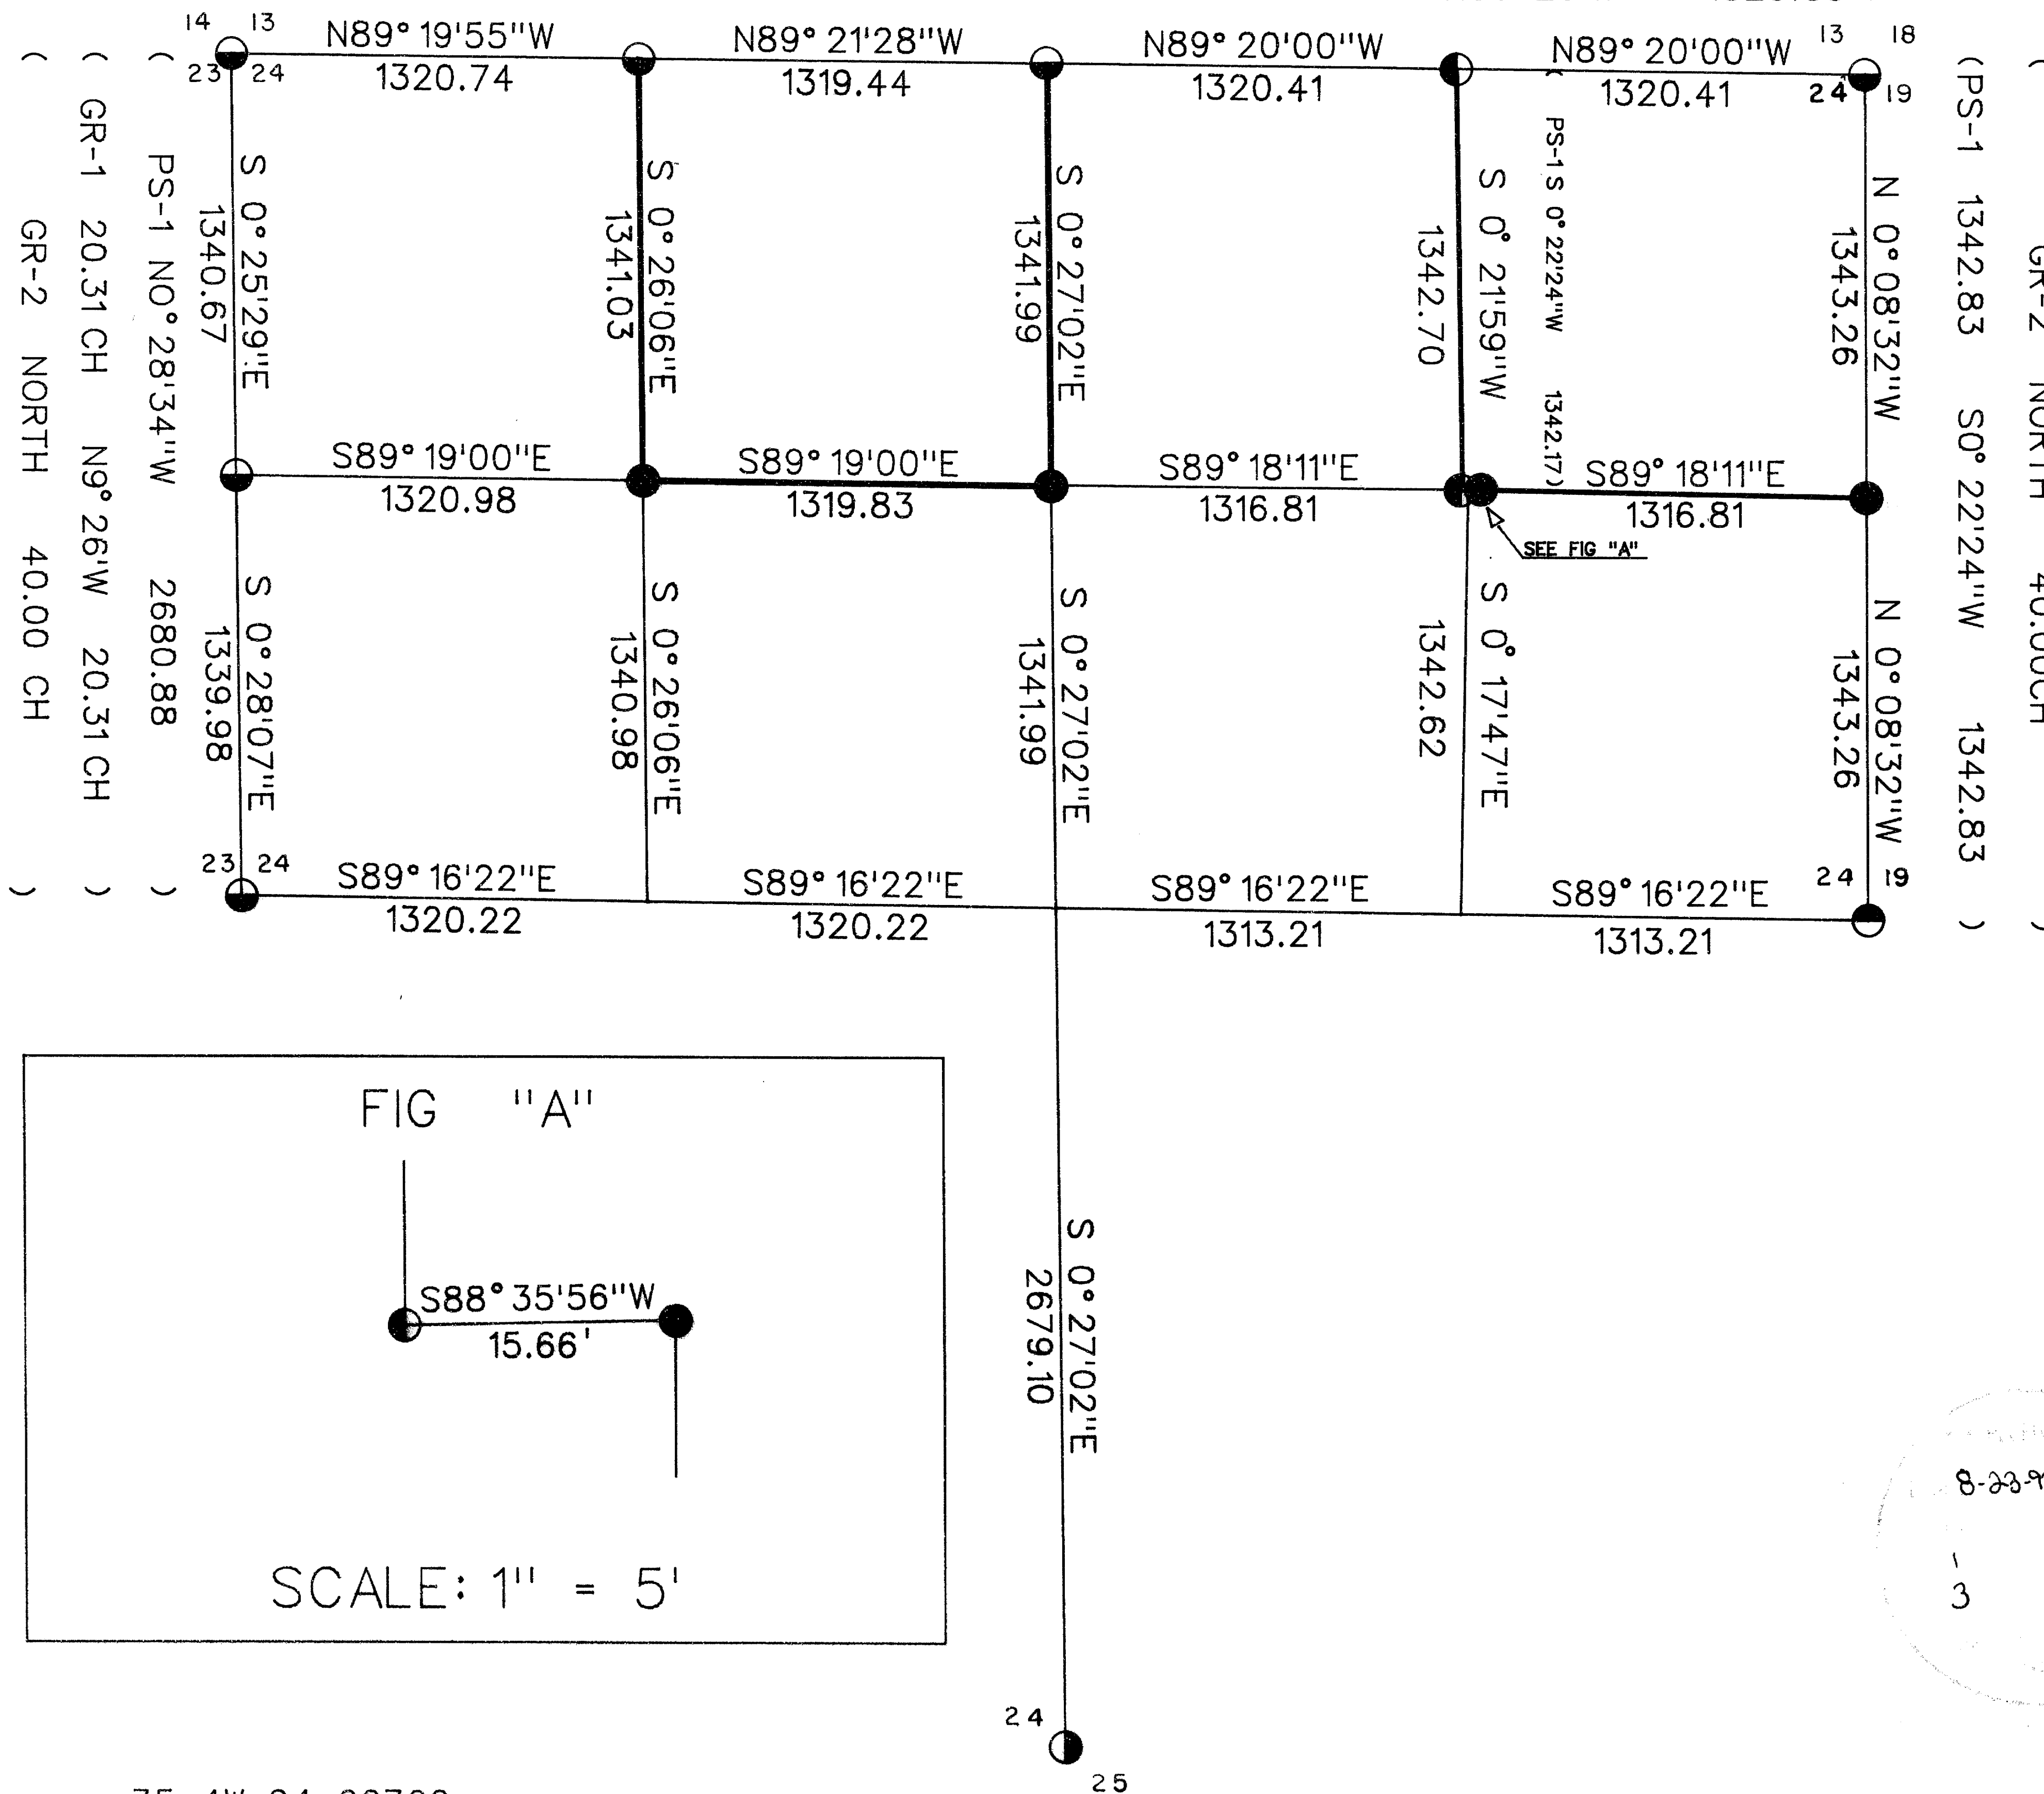

CERTIFICATE OF SURVEY

I, ARTHUR R. RAMBO, REGISTRATION No.1086 REGISTERED PROFESSIONAL LAND SURVEYOR STATE OF OREGON, HEREBY CERTIFY THAT THIS MAP CORRECTLY REPRESENTS A SURVEY MADE BY ME OR UNDER MY DIRECTION IN CONFORMANCE WITH THE LAWS OF THE STATE OF OREGON.

LEGEND

- SET⁵/₈" BY 30" REBAR WITH 2" ALUM. CAP
- ◐ FOUND STANDARD SIZED B.L.M. BRASS CAP
- ◑ FOUND STANDARD SIZED B.L.M. ALUM. CAP
- ◒ FOUND STANDARD COUNTY BRASS CAP
- ◓ FOUND PLASTIC CAP MARKED DW EDWARDS LS741
- PS-1 SURVEY No. 10014
- PS-2 SURVEY No. 9493
- GR-1 JULY 6,1982 B.L.M. DEPENDENT RESURVEY
- GR-2 1857 GOVERNMENT RECORD
- LINE POSTED AND BLAZED THIS SURVEY

SCALE



1" = 500'

BASIS OF BEARING

RECORDED SURVEY No. 10014
 EAST HALF NORTH LINE

DATE

JULY 15, 1993

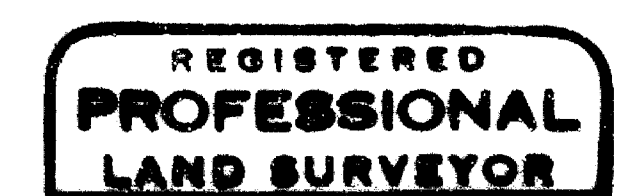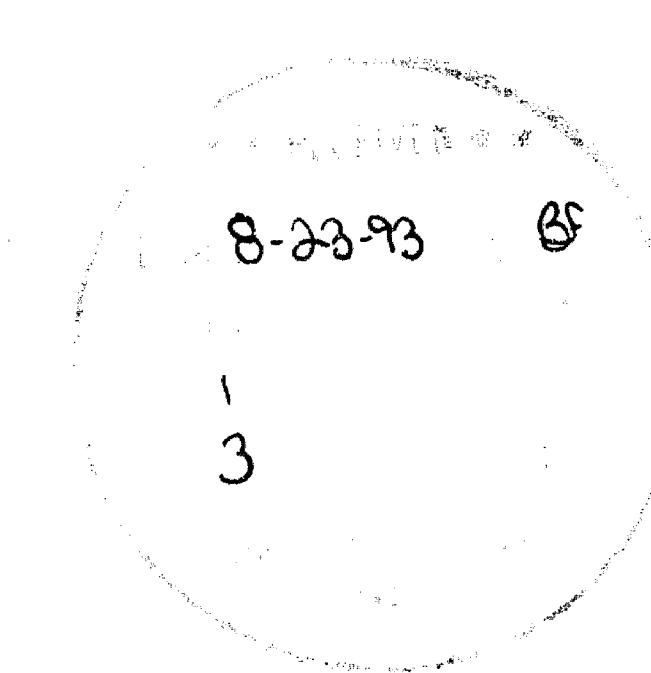

Arthur R. Rambo
 OREGON
 ARTHUR R. RAMBO
 No. 1086

REGISTRATION EXPIRES 31 DEC. 1994

TAX LOT No. 35-4W-24-00700





















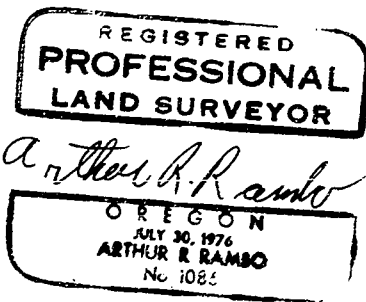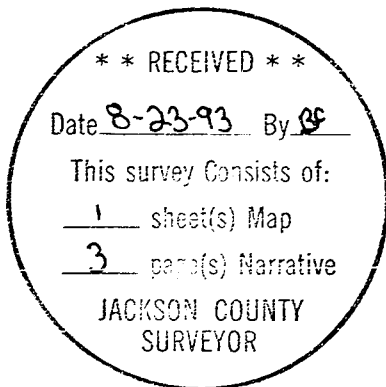

SOUTH CORNER 4 WEST. AT THE CORNER LOCATION I FOUND A BUREAU OF LAND MANAGEMENT 3 1/4 INCH DIAMETER ALUMINUM CAP EXPOSED 6 INCHES AND 2 BEARING TREES.

SECTION CORNER COMMON TO SECTIONS 14, 15, 23, AND 24 TOWNSHIP 35 SOUTH RANGE 4 WEST. AT THE CORNER LOCATION I FOUND A BUREAU OF LAND MANAGEMENT 3 1/4 INCH DIAMETER CAP EXPOSED 6 INCHES AND 4 BEARING TREES.

WEST QUARTER CORNER COMMON TO SECTION 24 TOWNSHIP 35 SOUTH RANGE 4 WEST AND 1/4 SECTION 19 TOWNSHIP 35 SOUTH RANGE 2 WEST. AT THE CORNER LOCATION I FOUND A STANDARD BUREAU OF LAND MANAGEMENT BRASS CAP EXPOSED 6 INCHES AND 3 BEARING TREES.

EAST QUARTER CORNER COMMON TO SECTIONS 24 AND 25 TOWNSHIP 35 SOUTH RANGE 4 WEST. AT THE CORNER LOCATION I FOUND A 2 1/2 INCH DIAMETER BRONZE CAP EXPOSED 6 INCHES AND 3 BEARING TREES.

WEST QUARTER CORNER COMMON TO SECTIONS 13 AND 24 TOWNSHIP 35 SOUTH RANGE 4 WEST. AT THE CORNER LOCATION I FOUND A BUREAU OF LAND MANAGEMENT 3 1/4 INCH DIAMETER ALUMINUM CAP EXPOSED 6 INCHES AND 2 BEARING TREES.

EAST QUARTER CORNER COMMON TO SECTIONS 24 AND 19 TOWNSHIP 35 SOUTH RANGE 4 WEST. AT THE CORNER LOCATION I FOUND A 3 1/4 INCH BRONZE CAP EXPOSED 3 1/2 INCHES AND 3 BEARING TREES.

EAST QUARTER CORNER COMMON TO SECTIONS 24 AND 24 TOWNSHIP 35 SOUTH RANGE 4 WEST. AT THE CORNER LOCATION I FOUND A 3 1/4 INCH DIAMETER ALUMINUM CAP EXPOSED 6 INCHES AND 3 BEARING TREES.

SOUTH QUARTER CORNER COMMON TO SECTIONS 23 AND 24 TOWNSHIP 35 SOUTH RANGE 4 WEST. AT THE CORNER LOCATION I FOUND A 3 1/4 INCH DIAMETER ALUMINUM CAP EXPOSED 6 INCHES AND 2 BEARING TREES.

WEST QUARTER CORNER COMMON TO SECTIONS 24 AND 24 TOWNSHIP 35 SOUTH RANGE 4 WEST. AT THE CORNER LOCATION I FOUND A 3 1/4 INCH DIAMETER ALUMINUM CAP EXPOSED 6 INCHES AND 2 BEARING TREES.

D.W. HOWARD
10/24/80

FIELD NOTES

ALL MARKERS FOUND BY ME WERE EXPOSED 12 INCHES APPROXIMATELY ABOVE THE GROUND SURFACE.

WEST QUARTER CORNER COMMON TO SECTIONS 24 AND 15 TOWNSHIP 35 SOUTH RANGE 4 WEST. AT THE CORNER LOCATION I FOUND A YELLOW BRASS CAP ON MARKER EXPOSED 1 1/2 INCHES MARKED:

D.W. HOWARD
10/24/80

NOTE: THIS CORNER IS ORIENTED SOUTH.

REMARKS AND COMMENTS

ALL BEARING TREES ARE TO THE CENTER OF TREE AT THE MARKER UNLESS OTHERWISE NOTED.

WEST QUARTER CORNER SECTION 24 TOWNSHIP 35 SOUTH RANGE 4 WEST. AT THE CORNER LOCATION I FOUND A 3 INCH DIAMETER ALUMINUM CAP ON A 2 1/2 INCH REBAR EXPOSED 9 INCHES MARKED:

D.W. HOWARD
10/24/80
10/24/80















