

Survey No. 1364

Paul Rynning
County Surveyor
Jackson County,
Medford, Oregon
January, 31, 1960

Township 36 South, Range 3 East. W.M.

SUBJECT: Re-establishment of 1/4 corner between Sec. 19 and 20,
requested by O. & C. of B.L.M. to Ross Lumber Co.



Found a brass cap on a 3/4 inch iron pipe, 36 inches long, lying
beside B T, which had been removed for road construction.

Set said pipe at corner as requested, which falls on the east edge
of the road, 12 inches in the ground to solid rock, from which

A downed fir snag, 18" diam., bears S.81°E., 54.78 ft.
(bearing tree of re-survey by BLM, 1956)

A fir, 38 ins. diam., bears S.84 $\frac{1}{2}$ °W., 58.74 ft.

Scribed yew, 12 ins. diam., 301 B T, bears N.23 $\frac{1}{2}$ °E., 54.8 ft.

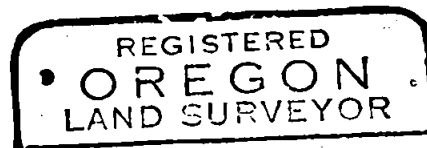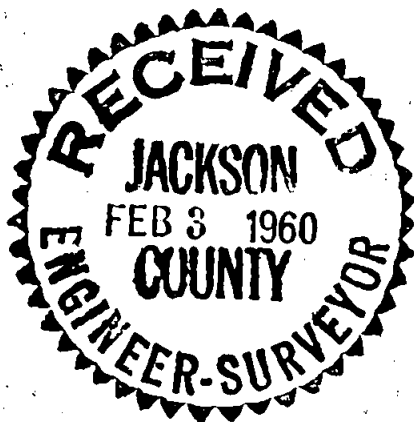

Edward A. McGinty

