

3 REC. POSITION
 10 1320.00' REC. 5.89° 51' 00" W. 2640.00'
 REC. POSITION E 1/6 COR.
 11 1320.00'
 REC. POSITION N 1/6 COR.
 REC. POSITION C.N. 1/6 COR.
 REC. POSITION NE 1/6 COR.
 REC. 5.89° 48' 00" W. 1320.00'
 REC. POSITION E/L SEC. 10
 REC. POSITION N 1/6 COR.

PROPERTY SURVEY

FOR


MISS HELEN MACE

N.E. 1/4 SEC. 10, T. 38 S., R. 2 W., W.M.

JACKSON COUNTY, OREGON

L.P. LOVEJOY L.S. MEDFORD, ORE.

SCALE: 1" = 300' NOV. 2, 1959

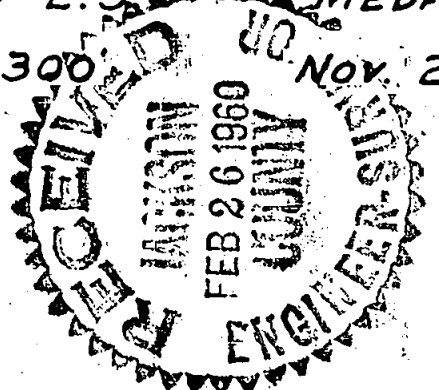

REGISTERED
 OREGON
 LAND SURVEYOR
Leland P. Lovejoy
 NOVEMBER 18 1949
 LELAND P. LOVEJOY
 262

SE 1/4 OF NE 1/4
 SEC. 10 T. 38 S., R. 2 W., W.M.
 TRACT "A" 10.81 AC.±
 TRACT "B" 10.80 AC.±
 TRACT "C" 10.84 AC.±

POSITION S.W. COR. GOVT. LOT 2
 READ DIR 425/226
 764.39

REC. NORTH 1321.15'
 1136.35'

SET 5/8" STEEL PINS
 NORTH 1316.14'
 SOUTH 1317.39'

899.40'
 SOUTH 1317.39'

1318.63'

727.26'
 NORTH 1109.92'

SET 5/8" STEEL PINS

740.37'
 SOUTH 1320.00'

REC. NORTH 1320.00'

D.L.C. #47

REC. POSITION C 1/4

REC. POSITION CE 1/6 COR.

REC. E & W 1/4 SEC. 10

RECORD BEARINGS USED.

REC. 290.40'
 179.04'

REC. GOVT.
 215.00'

SET 5/8" STEEL PINS
 LOT 2

N/L LOT 2
 S/L LOT 2

FD 5/8" STEEL PINS
 WEST 208.71'

REC. POSITION

FD. N.W. COR.
 D.L.C. #48

REC. 1320.00'
 REC. EAST
 N/L D.L.C. #48

FD 5/8" STEEL PINS

25.00'
 SET 5/8" STEEL PIN

WEST

FD. S.W. COR.
 D.L.C. #47

GRIFFIN CR. ROAD
 FD. N.E. COR.
 D.L.C. #48

1370

Survey Narrative to Comply with Section 87-330
1947 Oregon State Laws


Survey for: Mrs. Helen Mace
2231 Canal
Medford, Oregon

Purpose of Survey: To establish property boundaries and subdivide tract into three parcels

Survey Location: Section 10, Township 38 South, Range 2 West, Willamette Meridian, Jackson County, Oregon.

Survey Procedure: Found D. L. C. corners and other survey points as indicated on map. Used record measurements and bearings to determine record position of Section lines and corners, as original corners and evidence thereof has been destroyed. Set 5/8" steel pins.

Leland P. Lovejoy
Registered Land Surveyor
Work Completed November 15, 1959

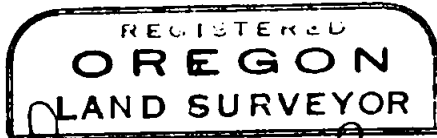

Leland P. Lovejoy

