

13701

**Survey for**

U.S. West Communications, Inc.  
132 W. Fourth Street  
Medford, Oregon 97501

**Located**

In Block 3, Orchard Home Association  
NW 1/4, Sec. 36, T. 37S., R. 2W., W.M.,  
City of Medford, Jackson County,  
Oregon

**Survey by**

Boyden Surveyors  
108 Mistletoe Street  
Medford, Oregon  
97501

**Date**

October 15, 1993

**Legend**


- Found monument as indicated
- Set 5/8" x 30" Rebar with red plastic cap stamped "BOYDEN RLS 281"

372W-368A TL 2002


Fd. FLUSH CONG. MON. 1  
2" BRASS DISK STAMPED  
"INITIAL POINT LEXINGTON VILLAGE  
SUBD. UNIT No. 1 LS 1913"

Fd. YELLOW CAP  
STAMPED "D.M. MAHON  
LS 1913"

LEXINGTON  
VILLAGE  
SUBDIVISION  
UNIT No. 1

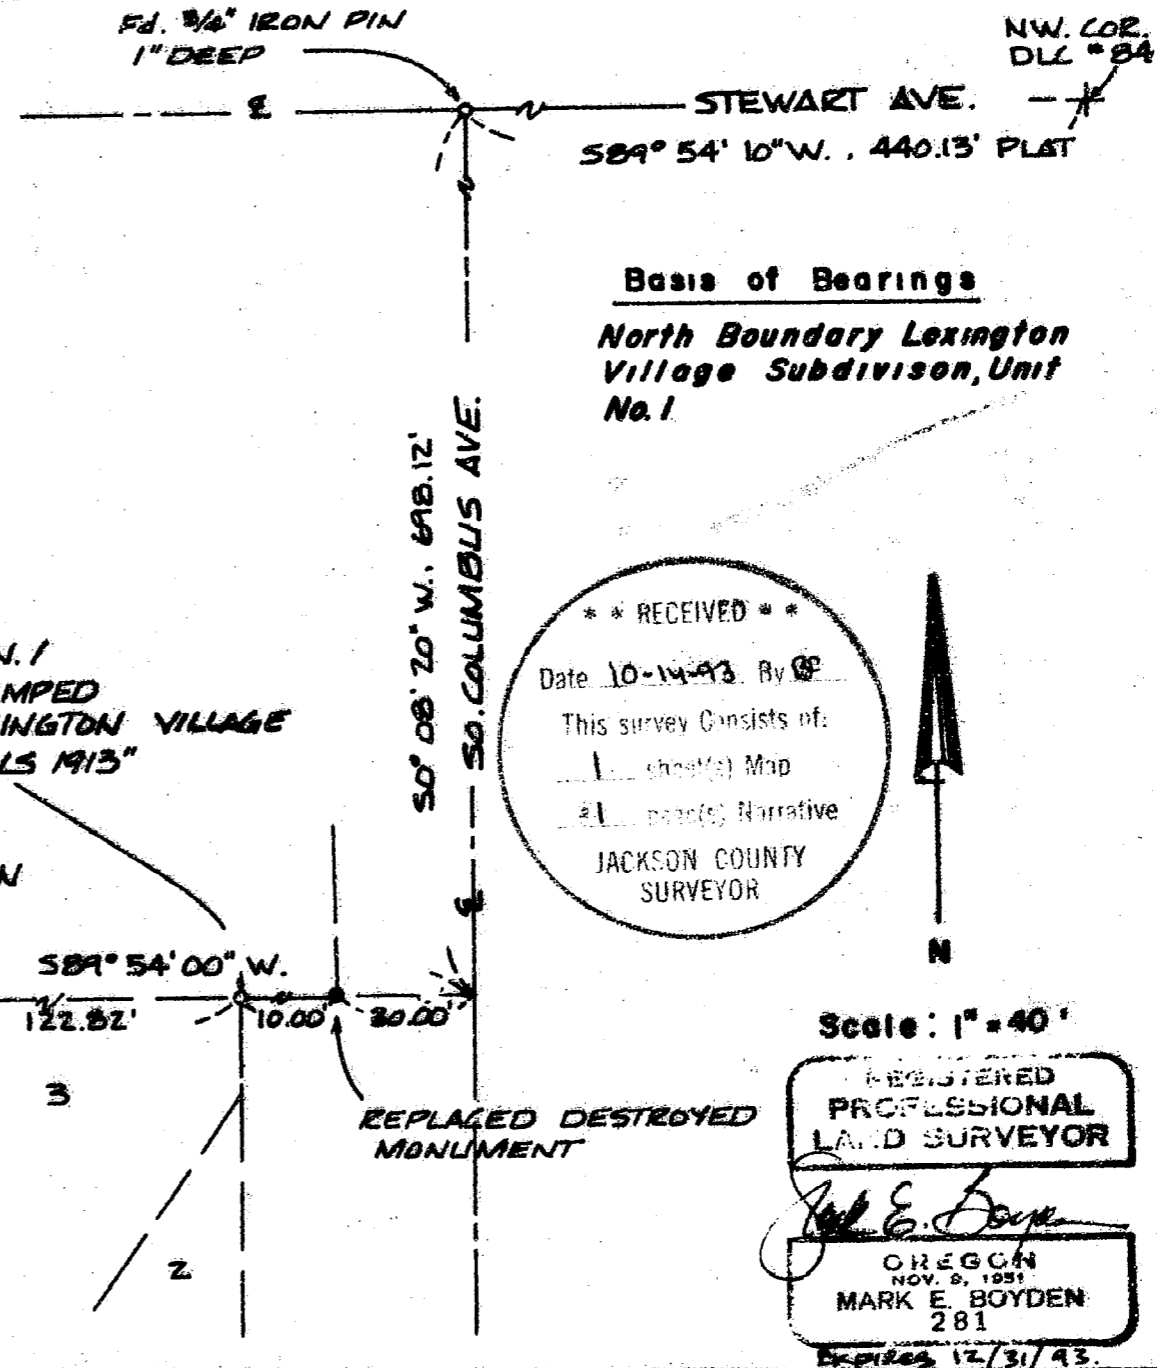

13701

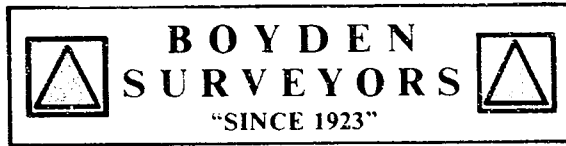

MARK E. BOYDEN  
R.P.L.S. ORE. 281  
108 MISTLETOE ST., MEDFORD, OREGON 97501  
PHONE (503) 773-6000

SURVEY NO. 13701

SURVEY NARRATIVE TO COMPLY WITH O.R.S. 209.250

SURVEY FOR: U. S. WEST COMMUNICATIONS, INC.  
132 W. FOURTH STREET  
MEDFORD, OREGON 97501

SURVEY BY: BOYDEN SURVEYORS  
108 MISTLETOE STREET  
MEDFORD, OREGON 97501

LOCATION: Block 3, ORCHARD HOME ASSOCIATION  
NW ¼, SEC. 36, T. 37S., R. 2W., W.M.  
CITY OF MEDFORD, JACKSON COUNTY,  
OREGON

BASIS OF BEARINGS: LEXINGTON VILLAGE SUBDIVISION, UNIT  
NO. 1 (Recorded)

DATE: OCTOBER 15, 1993

PURPOSE: To reset the monument destroyed by  
utility construction, being North  
89° 54' East, 10.00 feet from the  
Initial Point of LEXINGTON VILLAGE  
SUBDIVISION, UNIT NO. 1.

PROCEDURE: Utilizing E.D.M. equipment, found  
monuments at the Northwest and Northeast corners of Lot 3  
(also the Initial Point of LEXINGTON VILLAGE SUBDIVISION,  
UNIT NO. 1) and projected same Easterly 10.00 feet and set a  
new monument. Also tied in the 3/4" pin at the centerline of  
Stewart Avenue and South Columbus Avenue for an additional  
check.

\*\* RECEIVED \*\*  
Date 10-14-93 By MB  
This survey Consists of:  
1 sheet(s) Map  
1 page(s) Narrative  
JACKSON COUNTY  
SURVEYOR

REGISTERED  
PROFESSIONAL  
LAND SURVEYOR

*Mark E. Boyden*  
OREGON/  
NOV. 9, 1951  
MARK E. BOYDEN  
281  
EXPIRES: 12/31/93.