

MAP OF SURVEY

LOCATED in the SW 1/4 of the
SW 1/4 of Section 11,
T. 36 S., R. 4 W., W.M.,
in Jackson County, Oregon.

October 5, 1993

SURVEYED FOR: *Marjo Elken*
P.O. Box 1257
Rogue River, Oregon 97537




SURVEYED BY: *Edwards Surveying and Land Planning, Inc.*
823 West 8th Street
Medford, Oregon 97501
Phone (503) 776-2313

REGISTERED
PROFESSIONAL
LAND SURVEYOR

David A. Edwards

OREGON
JULY 26, 1968
DAVID A. EDWARDS
2339

Expires 12/31/93

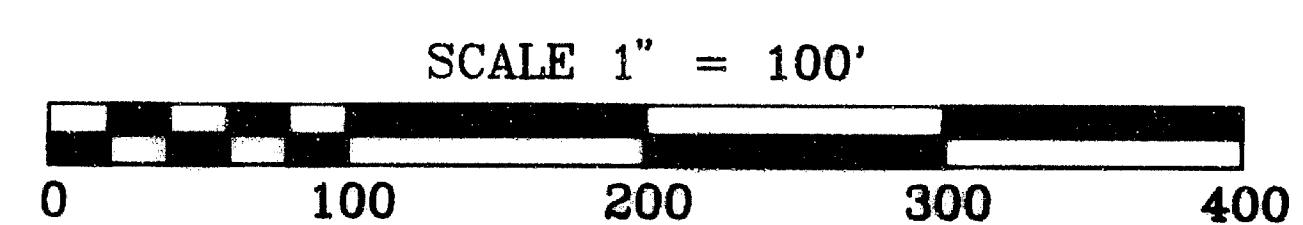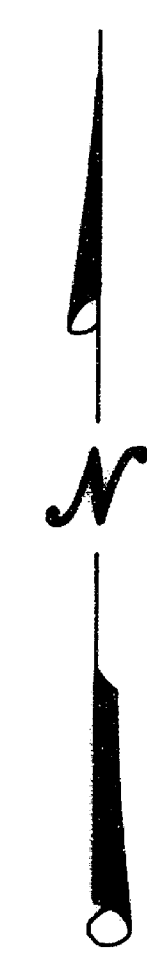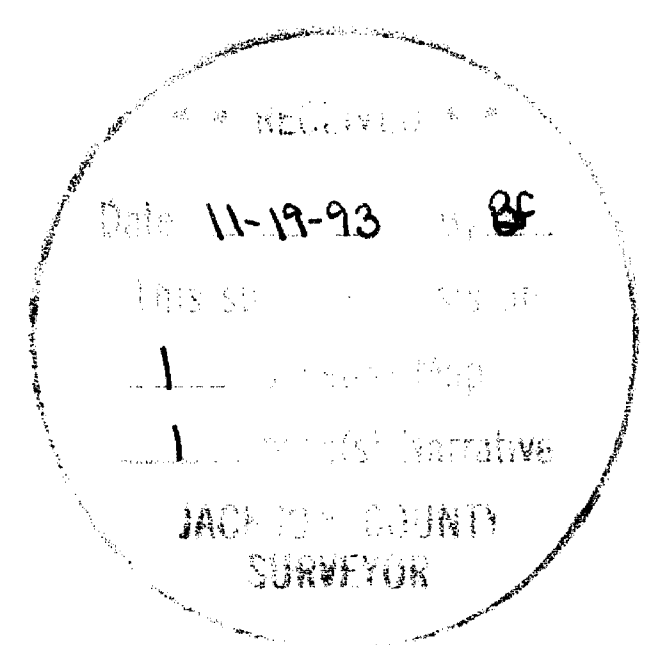

- LEGEND**
- Indicates 1993 B.L.M. Br. cap fd. unless noted otherwise.
 - Indicates 5/8" diam. I. Pin w/cap mkd. "LS-961" not of record fd. unless noted otherwise.
 - Indicates 5/8" x 24" steel pin w/red plastic cap mkd. "D.A. EDWARDS-LS 2339" set.
- J.C.S. = Jackson County Surveyor
S.N. = Survey Number B.L.M. = Bureau of Land Management
- BASIS OF BEARINGS: South line of SW 1/4 of SW 1/4 per unfiled B.L.M. Survey.

Edwards Surveying & Land Planning Inc.

DARREL W. EDWARDS
OREGON REG. 741
ARIZONA REG. 9746



DAVID A. EDWARDS
OREGON REG. 2339

REGISTERED LAND SURVEYORS
823 WEST 8TH ST.
MEDFORD, OREGON 97501
(503) 776-2313 • (503) 471-7059

SURVEY NUMBER 13727

SURVEY NARRATIVE TO COMPLY WITH CHAPTER 209, PARAGRAPH 250,
OREGON REVISED STATUTES

SURVEY FOR: Marijo Elskan
P.O. Box 1257
Rogue river, Oregon 97537

LOCATION: In the SW 1/4 of the SW 1/4 of Section 11,
T. 36 S., R. 4 W., W.M., in Jackson County,
Oregon.

PURPOSE: To locate and monument the boundaries of tract
described in Document Number 80-11237, Official
Records for Jackson County, Oregon.

PROCEDURE: Utilizing for control the found monuments per
an unfiled B.L.M. survey done in 1993 as shown
on the accompanying map, computed the desired
boundaries. Each of the boundaries of the tract
were traversed and flagged. Monuments set on
this survey consist of 5/8" x 24" steel pins
with red plastic caps mkd. "D.A. EDWARDS-LS
2339".

BASIS OF
BEARINGS: South line of SW 1/4 of SW 1/4 per unfiled
B.L.M. survey.

EQUIPMENT: Nikon DTM-A5 Electronic Total Station.

DATE
COMPLETED: October 5, 1993.

