


1379

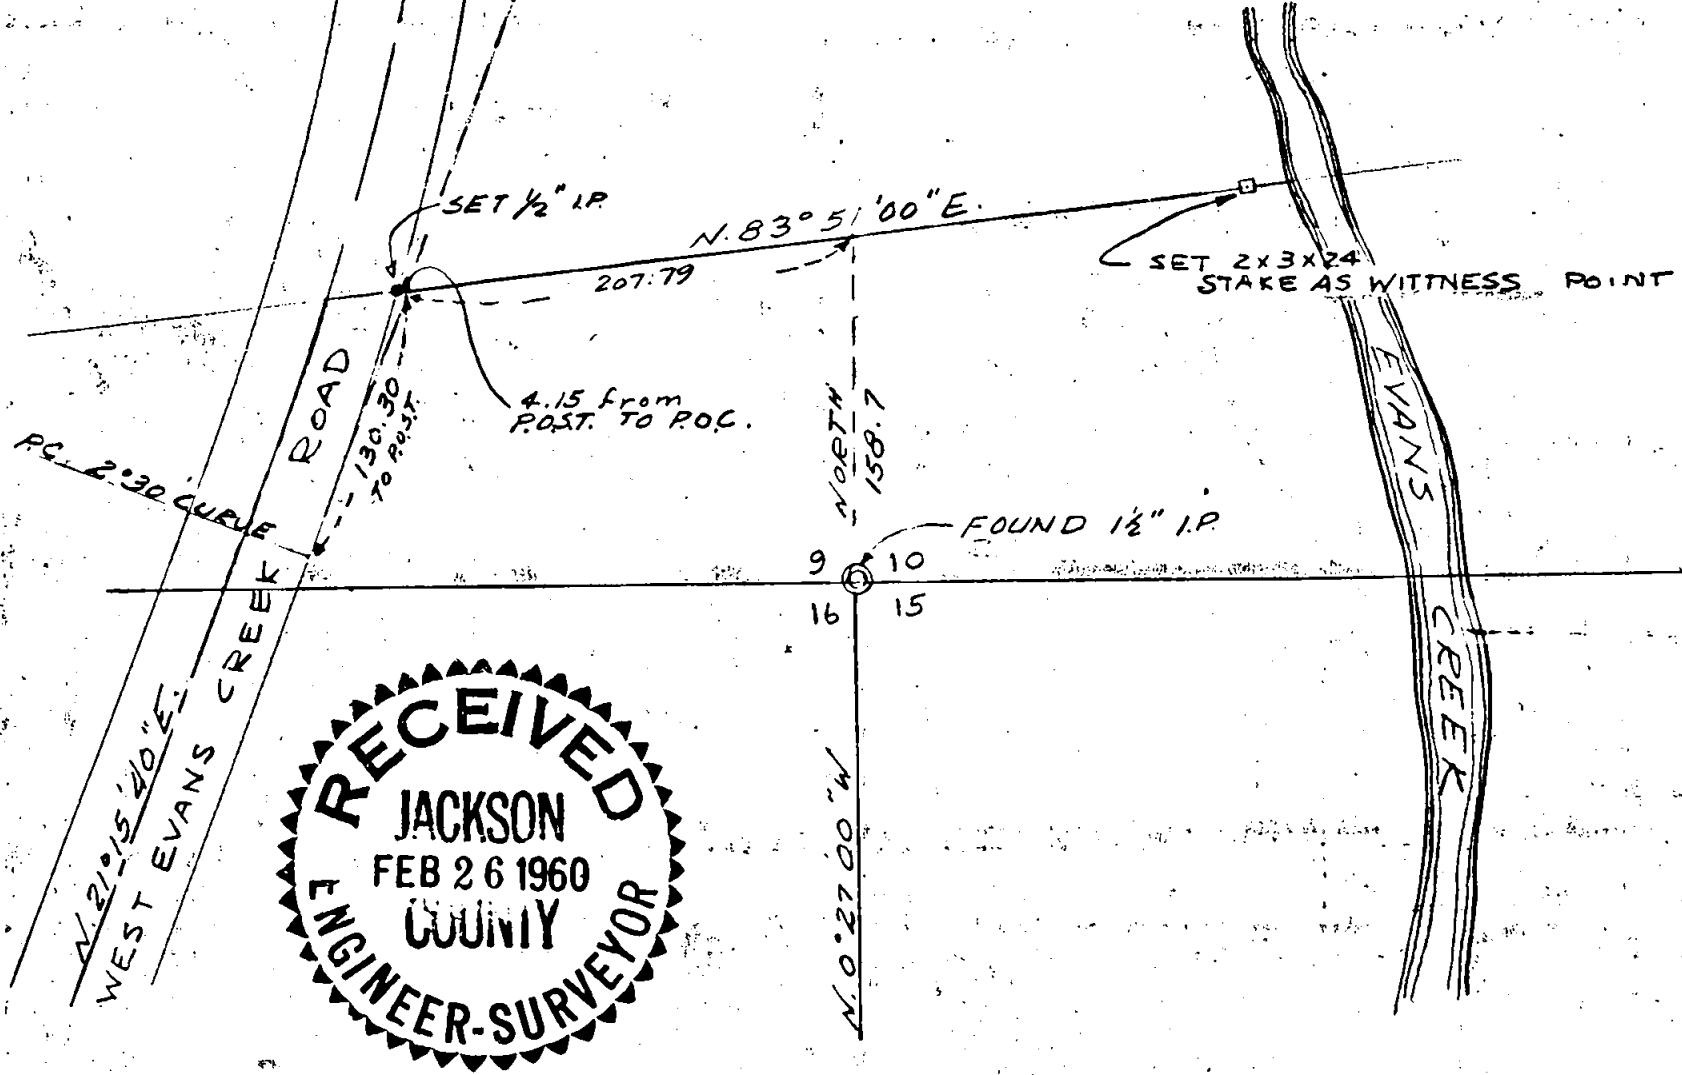

## SOURCES:

COUNTY SURVEYOR  
REESTAB. CORNERS

COUNTY ENGINEER  
REESTAB. CENT LINE OF  
WEST EVANS CREEK RD.

CONDITIONAL SALE CONT.  
TO JOHN WERRE 2 OCT. 1954

MERRIDIAN

RECORD BEARING OF  
RESURVEY OF SEC. LINE  
BET. SECS. 15 & 16, COUNTY  
SURVEYOR

JOHN WERRE

DATE 12 FEB. 1960

SECS. 9 &amp; 10 TWP. 36 S. RGE. 4 W.

SCALE, 1" = 100 ft.

DRAWN BY L.B.C.

COUNTY JACKSON

REGISTERED  
OREGON  
LAND SURVEYOR

MAY 2, 1968  
LEE B. COON  
439

LEE B. COON, SURVEYOR  
GRANTS PASS,  
OREGON

1379

LEE B. COON  
REGISTERED SURVEYOR  
PHONE GR 9-2360

POST OFFICE BOX 451

GRANTS PASS, OREGON

SURVEY FOR JOHN WERRE  
IN  
SECS. 9 AND 10, T. 36 S., R. 4 W.

The point of prime control for this survey is the  $1\frac{1}{2}$  in. pipe monumenting the cor. common to secs. 9, 10, 15, and 16, that is located 2 ft. south of the power pole on the northerly bdy. of the Wentworth property. This is the off. cor. as shown in the record of "reestablished corners", Jackson County Surveyor.

The meridean for this survey is the record bearing for the line bet. secs. 15 and 16, as shown in the resurvey of that line by the county surveyor.

The centerline of West Evans Creek Road was reestablished from the reference points as shown in the notes of the Reestablishment Survey of West Evans Creek Road, County Road Engineer.

All bearings are derived by angulation carried forward from the controlling meridean.

The authority for this survey is the Conditional Sale Contract to John Werre dated the 2nd day of Oct., 1954.

