MAP OF SURVEY - 93 - 77 - LLA


LOCATED in the NW 1/4 of Section 33 and NE 1/4 of Section 32, T. 35 S., R. I W., W.M., Jackson County, Oregon

SURVEYED FOR: Vernon Lehman

P.O. Box 579 Eagle Point, OR 97524 October 20, 1993

SURVEYED BY: Edwards Surveying and Land Planning, Inc. 823 West 8th Street

Medford, Oregon 97501

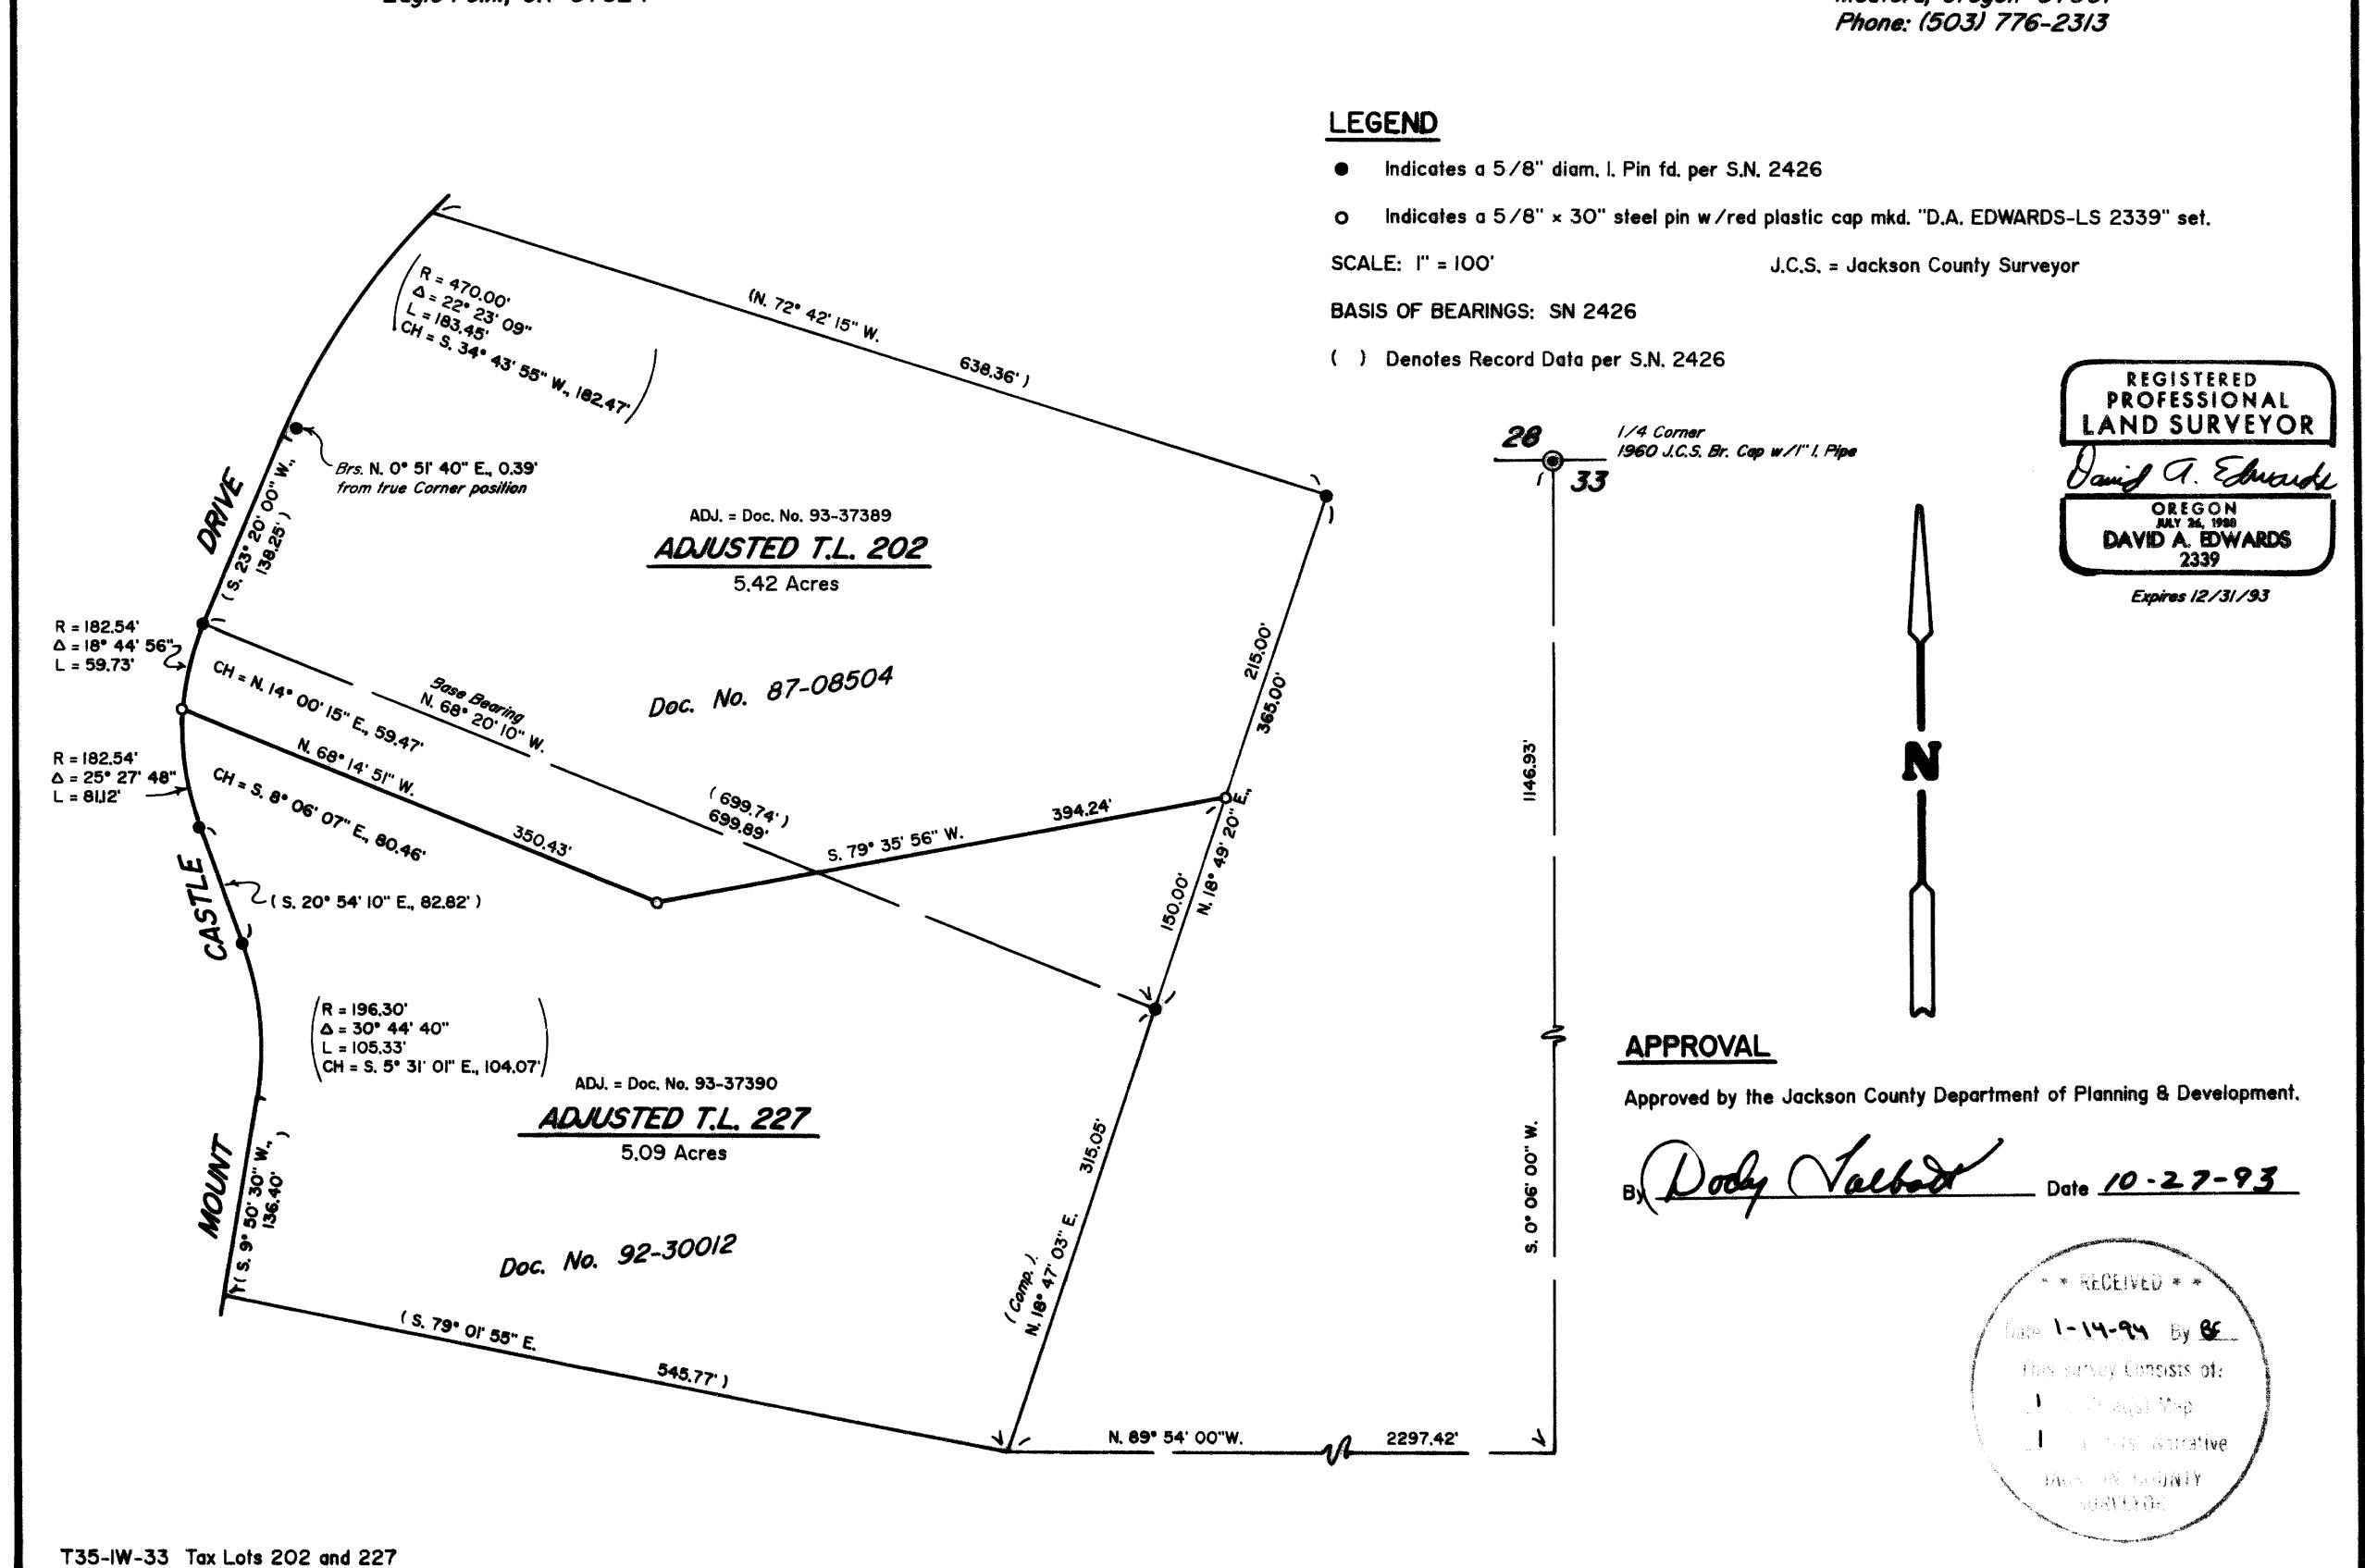

Edwards Surveying & Land Planning Inc.

816 West 8th Street Medford, OR 97501 Tel.: (503) 776-2313 FAX: (503) 776-9978



223 SW "I" Street Grants Pass, OR 97526 Tel.: (503) 471-7059 FAX: (503) 471-7809

SURVEYING • ENGINEERING • PLANNING

13813

SURVEY NUMBER

SURVEY NARRATIVE TO COMPLY WITH CHAPTER 209, PARAGRAPH 250, OREGON REVISED STATUTES

SURVEY FOR:

Vernon Lehman

P.O. Box 579

Eagle Point, Oregon 97524

LOCATION:

In the NW 1/4 of Section 33 and the NE 1/4 of Section 32, T. 35 S., R. 1 W., W.M. in Jackson

County, Oregon.

PURPOSE:

Property Line Adjustment; Planning Dept. File No. 93-77-LLA: To locate and monument the new boundary of tax lots 202 and 227 as shown on the accompanying map and to prepare new legal descriptions for said adjusted tax lots.

PROCEDURE:

Utilizing for control the found monuments per Survey Number 2426, as well as data found in Documents Numbered 87-08504 and 92-30012, Official Records, computed the required boundary locations as shown. Only the new boundary was marked in the field. Monuments set on this survey consist of a 5/8" x 30" steel pins with red plastic caps mkd.

"D.A. EDWARDS-LS 2339".

BASIS OF

BEARINGS:

Survey Number 2426 as shown.

EQUIPMENT:

Nikon DTM-A5 Electronic Total Station.

DATE

COMPLETED:

October 20, 1993.

* * RECEIVED * *

Date \(\simeq - \simeq - \simeq - \simeq \)

This survey Consists of:

\(\simeq \)

sheet(s) Map

\(\simeq \)

page(s) Narrative

JACKSON COUNTY

SURVEYOR

PROFESSIONAL
LAND SURVEYOR

OREGON
DAVID A. EDWARDS
2339
EXPLOSE 12/31/95