



l" **-** 400'

## INDEX

- Found Jackson County Brass Cap per Reestablishment Book. Page 67
- Found B.L.M. Brass Cap per B.L.M. Book. Page 10
- Found B.L.M. Brass Cap monument per unofficial B.L.M. Casdastral Survey, 1992
- Set 5/8"x 30" Rebar with yellow plastic cap marked: "TEMPLIN LS 2359"
- ▲ Calculated corner position per B.L.M. unofficial Cadastral Survey

Bearings based upon the East line of the SE 1/4 of Section 18

Indicates true line brushed, blazed ( blazes painted red ) and tagged with aluminum Boise tags.

Survey narrative is a seperate document

\* \* RECEIVED \* \*

Date 1/31/94 By SC


This survey Consists of:

\_\_\_\_\_\_\_\_ sheet(s) Map

\_\_\_\_\_\_\_ pare(s) Narrative

JACKSTIN COMMITY

SURVEYOR

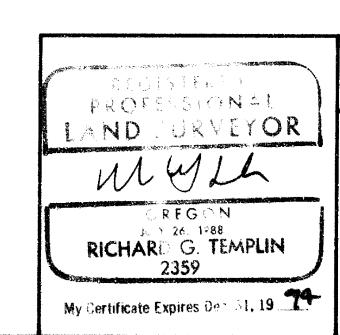

RICHARD TEMPLIN LAND SURVEYING
2042 SANDRA PL. 776-0991 & 474-7720 MEDFORD, OREGON

MAP OF SURVEY
LOCATED IN
The SE I/4 of Section 18
T.34S.. R.IW., W.M.

Jackson County, Oregon
SURVEYED FOR: Boise Cascade Corp.
P.O. Box 100
Medford, Or. 97501

34-1W-18-TL 600-

DATE: Janua ary 26, 1994

## RICHARD G. TEMPLIN

PROFESSIONAL LAND SURVEYOR

100 Poorman Creek Road Jacksonville, Oregon 97530 Phone/Fax: (503) 899-2032 • 474-7720

NARRATIV
----------

SURVEY NO.

SURVEY FOR:

Boise Cascade Corp.

P.O. Box 100

Medford, Oregon 97501

LOCATION:

In the SE 1/4 of Section 18, Township 34 South, Range 1 West, Willamette Meridian, Jackson County, Oregon.

PURPOSE:

To monument the North and East line of the S 1/2 of the SE 1/4 of Section 18.

DATE:

January 26, 1994

BASIS OF

BEARING:

Based upon the East line of the SE 1/4 of Section 18, per B.L.M. unofficial Cadastral Survey, date 1992.

PROCEDURE:

Utilizing a Nikon A-10 Total Station, tied the E 1/4 and the SE corner of Section 18, as shown. Using a copy of the B.L.M. unofficial Cadastral Survey map, I computed the CS 1/16 position. I then ran N 00004'30" East along the true line from the SE corner of Section 18 1323.42 feet, to the S1/16 corner common to Sections 18 and 17, at said corner set a 5/8"x 30" rebar with a yellow plastic cap marked "TEMPLIN LS 2359 ", from which I scribe the following bearing trees:

\* \* RECEIVED \* \*

Date 1/31/94 By5k

This survey Consists of:

\_\_\_\_\_ sheet(s) Map

\_\_\_\_ page(s) Carrative

JACKSON COUNTY
SURVEYOR

A Black Oak, 15" diameter bears N 78 1/20 W, 17.4 feet, scribed "El/16S18" "BT". A White Oak, 13" diameter bears S 41 1/20 W, 68.6 feet, scribed "El/16S18" "BT".

I then ran S 89044'02" W on true line, 2637.58 feet to a B.L.M. brass cap, being the CS 1/16 corner of Section 18, from which I find the following bearing trees:

A Douglas fir, 11" diameter, with partially healed blazes, bears S 41° W, 21.6 feet. A Douglas fir, 19" diameter, with partially healed blazes, bears S 43° E, 57.1 feet.

I scribe the following bearing tree:

A Cedar, 10" diameter bears S 880 W, 57.9 feet, scribed "CS1/16S18" "BT".

REGISTERED PROFESSIONAL LAND SURVEYOR

OREGON
JULY 26, 1988
RICHARD G. TEMPLIN
2359

My Certificate Expires Dac. 31. 19.94