

MAP OF SURVEY

Located in the Northwest 1/4 of Section 9,
T.37 S., R.1 W., W.M. Jackson County, Oregon

SURVEY NARRATIVE TO COMPLY WITH O.R.S. 209.250

PURPOSE: To survey and monument the Northerly line of Lot 3 of BUSH GARDENS SUBD. UNIT 1.

PROCEDURE: Tied in pins set on the official plat of BUSH GARDENS SUBD. Calculated the missing corners at right angles from the monuments found on the Northerly line of Dodson Road. Those monuments found as well as those set are as shown hereon.

SURVEY FOR:

Jack H. Adams
3565 Dodson Road
Medford, OR 97504

SURVEY BY:

L.J. Friar & Associates, P.C.
Consulting Land Surveyors
304 South Holly Street
Medford, Oregon 97501
Phone: (503) 772-2782


LEGEND:

- ⊙ = Found Brass disk in concrete per Official Plat BUSH GARDENS SUBD. UNIT 1.
- = Found 5/8" iron pin per Official Plat BUSH GARDENS SUBD. UNIT 1.
- = Set 5/8" x 24" iron pin with plastic cap mkd. L.J. FRIAR & ASSOC.
- () = Plat record data.

BASIS OF BEARINGS: Nly R/W Dodson Road per official plat BUSH GARDENS SUBD. UNIT 1.

DATE: January 17, 1994

SCALE: 1" = 30'

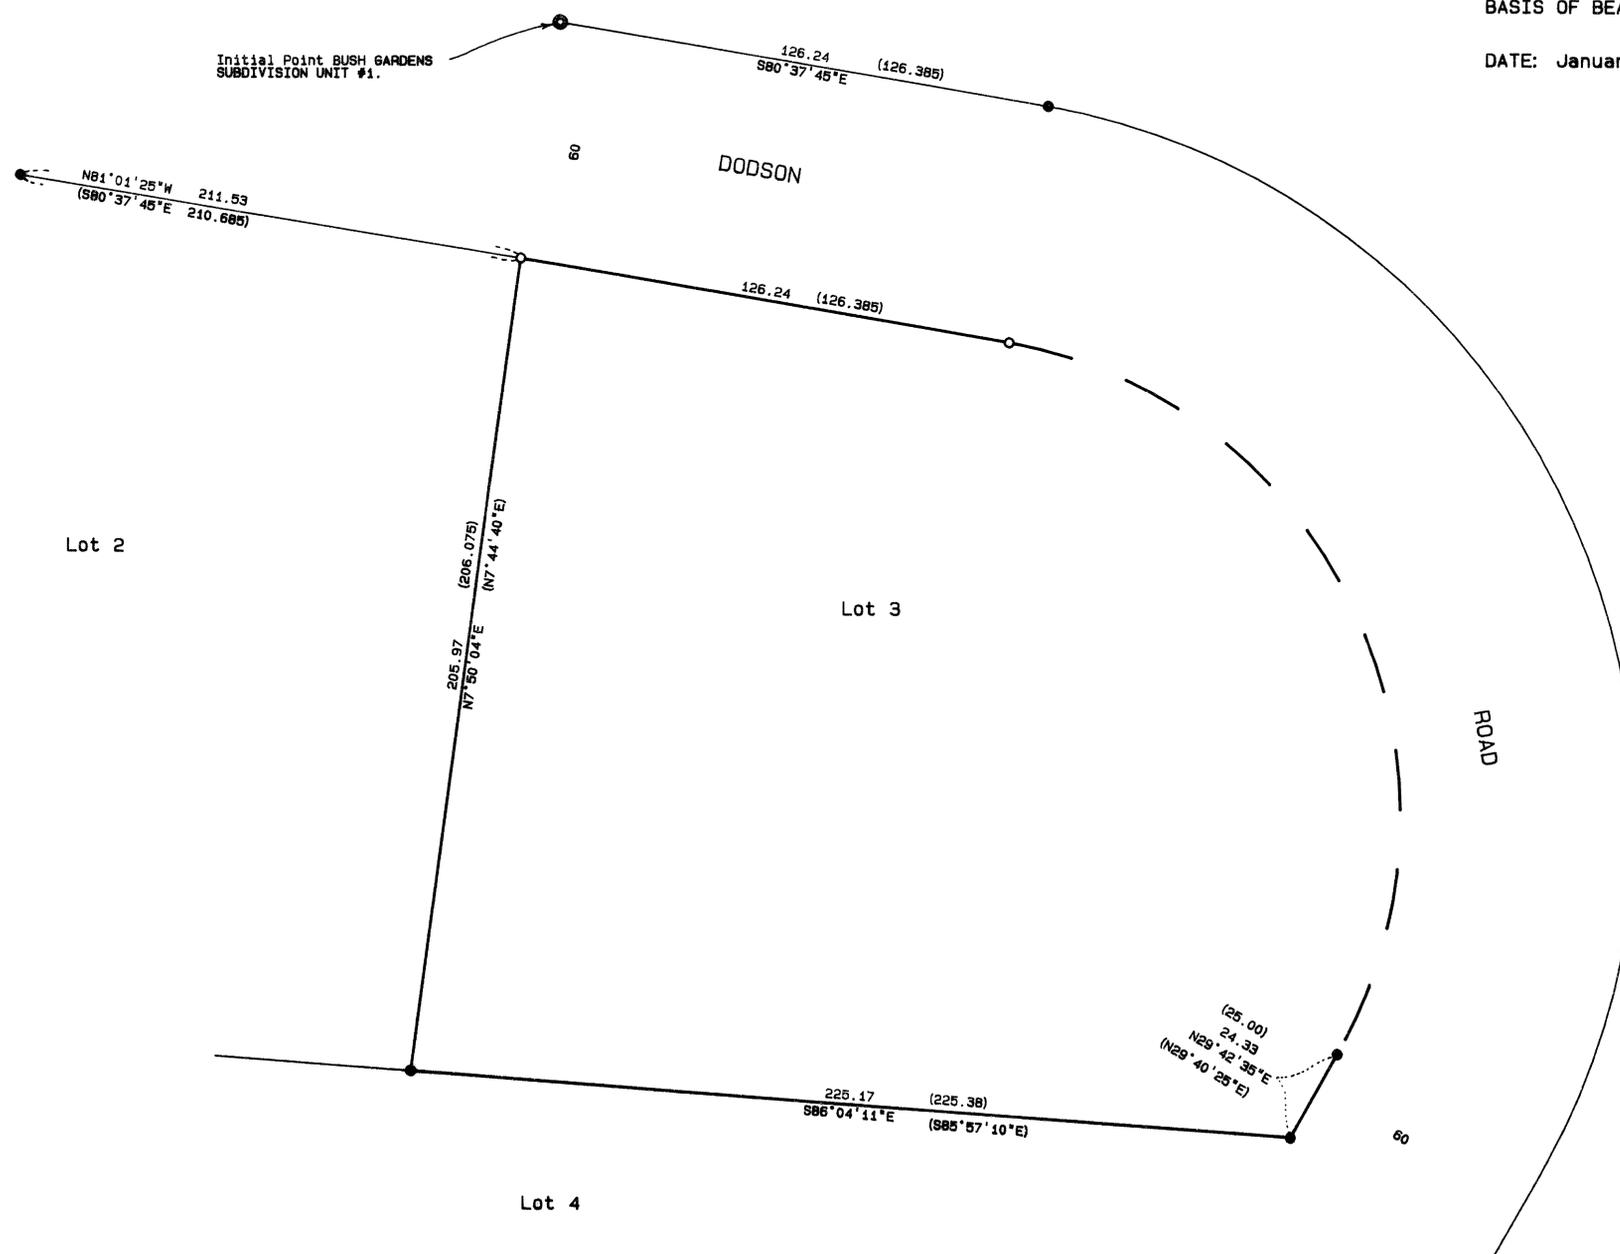

*** RECEIVED ***
Date: 2-2-94 By: J.E.H.
This survey consists of:
1. A Surveyed Map
2. A Survey Narrative

REGISTERED
PROFESSIONAL
LAND SURVEYOR
James E. Hibbs
OREGON
JULY 17, 1986
JAMES E. HIBBS
2234
Expires 6-30-95

371W09A TL3200