

NOTE:



- Indicates 5/8" X 30" Iron rod W/Red plastic Cap Marked "REECE-PLS 864" Set.
 - Indicates monuments found as shown.
- Bearings are based upon N-S Centerline Sec. 15, Per S.N. 6845.

APPROVED BY THE JACKSON COUNTY PLANNING DEPARTMENT
THIS 26 DAY OF January, 1994

Carol Parker

NARRATIVE

The purpose of this survey is to adjust the lines of land as described in Book 497 at Page 243 official records of Jackson County. Monuments were recovered and held per Survey S. N. 6845. Property corners were set as shown on the Plat. This survey was executed with a Nikon DTM-AS Total Station.

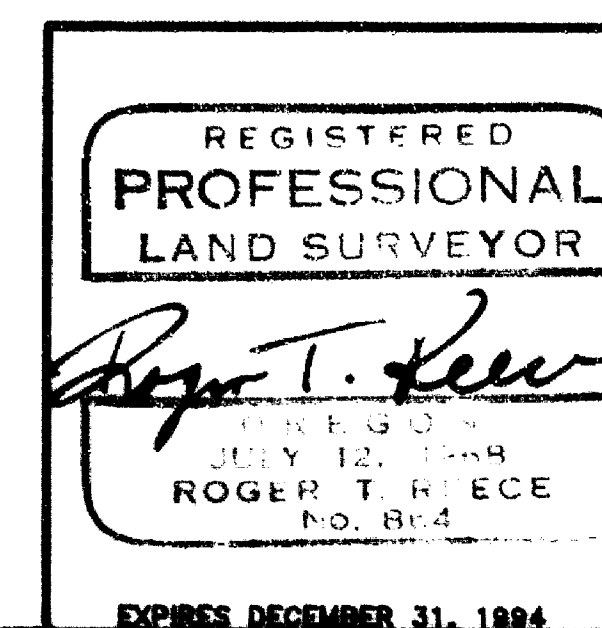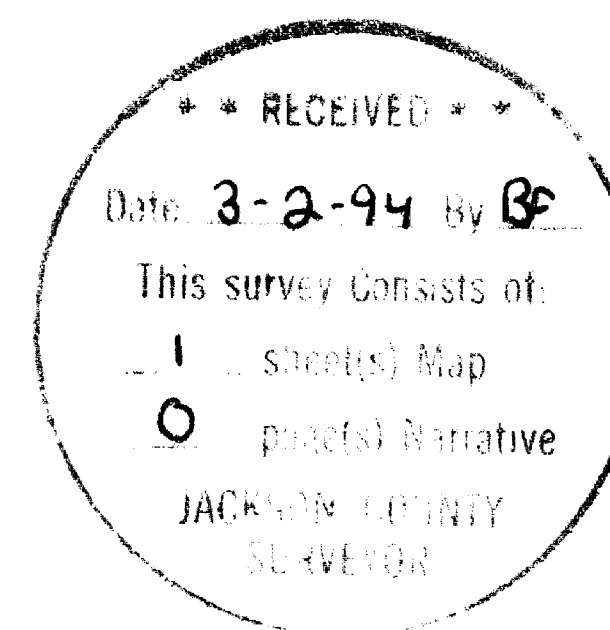

File No. 93-93-LLA

ROGER T. REECE
P.L.S. 864
321 NW "A" Street 476-4502 Grants Pass, Ore.

PROPERTY LINE ADJUSTMENT PLAT
TAX LOTS 3002 & 2900

LOCATED IN TRACTS 13 AND 14 OF PLEASANT VALLEY FARM TRACTS AND S. E. 1/4 AND THE S. E. 1/4 OF S. W. 1/4 OF SEC. 15 AND THE N. E. 1/4 OF THE N. W. 1/4 OF SEC. 22, T. 35 S., R. 4 W., W. M. JACKSON COUNTY OREGON

SURVEYED FOR: Mr. & Mrs. Denis Artoff Rogue River, Oregon
SCALE 1" = 200' January 20, 1994