

- LEGEND**
- SET 5/8" X 30" REBAR WITH YELLOW PLASTIC CAP MARKED " TEMPLIN LS2359 "
 - FD. ALUMINUM CAP PER O.S.H.D. DRAWING NO. 9B-3-7 CRATER LAKE HWY. - BROWNSBORO 1967
 - ⊙ FD. ANGLE IRON POST, BEARS S 89°40'38" W 0.26' FROM COMPUTED CORNER PER O.S.H.D. DRAWING NO. 9B-3-7 CRATER LAKE HWY. - BROWNSBORO 1967
 - FD. TACK IN FENCE POST INTERSECTION PER O.S.H.D. DRAWING NO. 9B-3-7 CRATER LAKE HWY. - BROWNSBORO 1967
 - ⊙ FD. BRASS CAP PER RS 7826
 - ⊠ FD. BRASS CAP PER JACKSON COUNTY REESTABLISHMENT BOOK, PAGE 60
 - △ CALCULATED POSITION
 - () RECORD BEARING/DISTANCE PER O.S.H.D. DRAWING NO. 9B-3-7 CRATER LAKE HWY. - BROWNSBORO 1967
 - (() RECORD BEARING/DISTANCE PER R.S. NO. 7826

BEARINGS BASED UPON R.S. NO. 7826

** NARRATIVE IS SEPARATE DOCUMENT **

** RECEIVED **
 Date 3-11-94 By [Signature]
 This survey consists of:
 - 1 Sheet Map
 - 1 Narrative
 JACKSON COUNTY SURVEYOR

REGISTERED PROFESSIONAL LAND SURVEYOR
 [Signature]
 RICHARD G. TEMPLIN
 2359

RICHARD TEMPLIN LAND SURVEYING
 2042 SANDRA PL. 774-0991 & 474-7720 MEDFORD, OREGON

MAP OF SURVEY
 LOCATED IN
 SE1/4 OF SECTION 5, T.26S., R.1E., W.M.
 JACKSON COUNTY, OREGON

SURVEYED FOR: MR. SKIP SANDERS DATE: OCTOBER 1, 1993
 P.O. BOX 8031
 CHARLESTON, OREGON

RICHARD G. TEMPLIN
PROFESSIONAL LAND SURVEYOR
2042 Sandra Pl.
Medford, Oregon 97504
(503) 776-0991 • 474-7720

NARRATIVE

SURVEY NO. 13919

SURVEY FOR: Mr. Skip Sanders
P.O. Box 5031
Charleston, Or. 97420




LOCATION: In the SE 1/4 of Section 5, Township 36 South,
Range 1 East, Willamette Meridian, Jackson
County, Oregon.

PURPOSE: To monument the Deed corners of O.R. 93-23677.

DATE: October 1, 1993

BASIS OF
BEARING: Based upon R.S number 7826.

PROCEDURE: Found monuments set by the Oregon State
Highway Department, date 1967 (O.S.H.D.
drawing number 9B-3-7. The northwest corner
of said O.R. 93-23677 was set by the O.S.H.D,
but has been destroyed due to ditch
maintenance. Replace said NW corner, as shown.

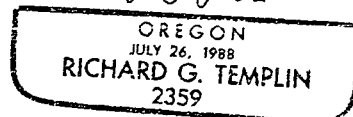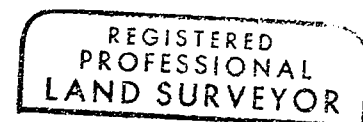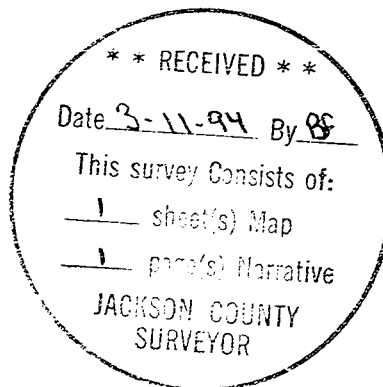

My Certificate Expires Dec. 31, 19 94