

1" = 300'

LEGEND

- Found 1977 B.L.M. Brass Cap monument
- Found Brass Cap monument per Recorded Survey number 9567
- Found Brass Cap monument per Jackson County Reestablishment Book, Page 7
- Set 5/8"x30" Rebar with yellow plastic cap marked "TEMPLIN LS 2350"
- △ Calculated position
- () Record bearing/distance per Recorded Survey number 9567
- (()) Record bearing/distance per B.L.M. 1977 survey
- [] Record bearing/distance per Recorded Survey number 12198
- Bearings based upon Recorded Survey number 12198
- Indicates true line brushed and flagged with Flo-Red ribbon.

97-4w-15-TL 401

**** RECEIVED ****
 Date 3-30-94 By RT
 This survey consists of:
 ... () ...
 ... () ...
 SURVEYOR

REGISTERED
 PROFESSIONAL
 LAND SURVEYOR
W. G. H.
 OREGON
 1988
 RICHARD G. TEMPLIN
 2359
 My Certificate Expires Dec. 31, 19 94

RICHARD TEMPLIN LAND SURVEYING
 100 POORMAN CREEK RD. 979-2882 / 474-7728 JACKSONVILLE, OREGON
MAP OF SURVEY
 LOCATED IN
 S1/2 OF THE SE1/4 OF SECTION 15, T.37S., R.4W., W.M.
 JACKSON COUNTY, OREGON
 SURVEYED FOR: Karen Thornton/David Traphagen
 4050 Right Fork Foot Cr. Rd.
 Gold Hill, OR.
 DATE: February 16, 1994

RICHARD G. TEMPLIN
PROFESSIONAL LAND SURVEYOR
100 Poorman Creek Road
Jacksonville, Oregon 97530
Phone/Fax: (503) 899-2032 • 474-7720

NARRATIVE

Survey No. 13940

SURVEY FOR: Karen Thornton/David Traphagen
4058 Right Fork Foots Cr. Rd.
Gold Hill, Oregon



LOCATION: In the SE 1/4 of Section 15, Township
37 South, Range 4 West, of the Willamette
Meridian, Jackson County, Oregon.

PURPOSE: To survey and monument The North and South 1/2 of
the S 1/2 of the S 1/2 of the SE 1/4 of said
Section 15.

DATE: February 15, 1994

BASIS OF Bearings based upon Recorded Survey number 12198.

PROCEDURE: Tied the SE corner of Section 15, EE 1/64 and the
E 1/16 between Sections 15 and 22, from previous
set control. Computed and set monuments at the
NW corners of the North and South 1/2 of the S
1/2 of the S 1/2 of the SE 1/4 of said Section
15. I then set witness corners at the
intersection of the Deed lines and the
approximate Westerly right of way line of Right
Fork Foots Cr. Rd.

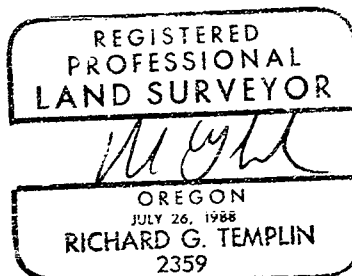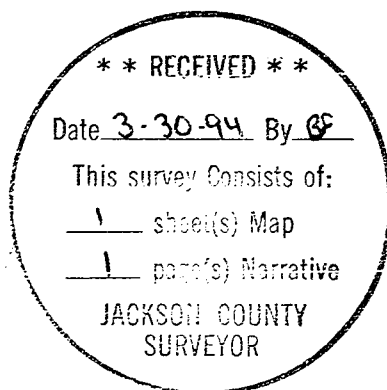

My Certificate Expires Dec. 31, 19__