

RICHARD G. TEMPLIN
PROFESSIONAL LAND SURVEYOR
100 Poorman Creek Road
Jacksonville, Oregon 97530
Phone/Fax: (503) 899-2032 • 474-7720

NARRATIVE

Survey No. 13979

PROPERTY LINE ADJUSTMENT

SURVEY FOR: Mr. Douglas Pickell
832 E. Main St. # 12
Medford, Oregon 97501



LOCATION: D.L.C No. 88, in the NE 1/4 of Section 23,
Township 37 South, Range 2 West, of the
Willamette Meridian, Jackson County, Oregon.

PURPOSE: To prepare a Property Line Adjustment map, as
instructed by my client.

DATE: January 10, 1994

BASIS OF Bearings based upon, R.S. 9540.

PROCEDURE: Prepared a Property Line Adjustment map and two
legal descriptions of the properties being
adjusted. Tied control monuments, as shown and
set monuments along the newly adjusted property
line and the Southwest corner of O.R. 94-14427.

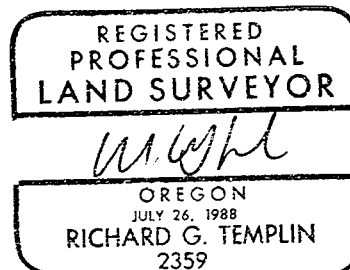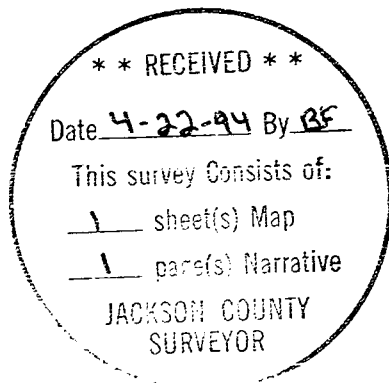

My Certificate Expires Dec. 31, 19 94