

MAP OF SURVEY
*In COUNTRYSIDE VILLAGE SUBDIVISION, PHASE 1, in
 the N.E. 1/4 of Sec. 11, T. 37 S., R. 2 W., W.M.
 City of Central Point Jackson County, Oregon*

SURVEY FOR:

Great American Homes
2811 Leonard Avenue
Medford, OR 97501

SURVEY BY:

L.J. Friar & Associates, P.C.
Consulting Land Surveyors
304 South Holly Street
Medford, Oregon 97501
Phone: (503) 772-2782

LEGEND:

- - Found 5/8" iron pin with plastic cap mkd. L.J. FRIAR & ASSOC. per COUNTRY VILLAGE SUBDIVISION.
- ⊙ - Found 1 1/2" brass disk in concrete mkd. L.J. FRIAR & ASSOC.
- - Set brass tag mkd. LS2234 in lead plug in top concrete curb.

BASIS OF BEARINGS: COUNTRYSIDE VILLAGE SUBDIVISION

DATE: July 8, 1994

SCALE: 1" = 20'

SURVEY NARRATIVE TO COMPLY WITH ORS 209.250.

PURPOSE: To reference centerline intersection monuments destroyed by manhole construction.

PROCEDURE: Prior to monument destruction set brass tags in lead plugs in top of concrete curb as shown hereon. Those monuments found as well as those set are as shown hereon.

REGISTERED
PROFESSIONAL
LAND SURVEYOR

James E. Hibbs

OREGON
JULY 17, 1986
JAMES E. HIBBS
2234
Renewal Date 6-30-95


** RECEIVED **

Date 8-12-94 By JEH

This survey consists of:
1 sheet(s) Map
0 page(s) Narrative

JACKSON COUNTY
SURVEYOR

Fd. 5/8" iron pin per RS9512. Brass disk destroyed. 1" iron pipe 0.17. E. Origin unknown.

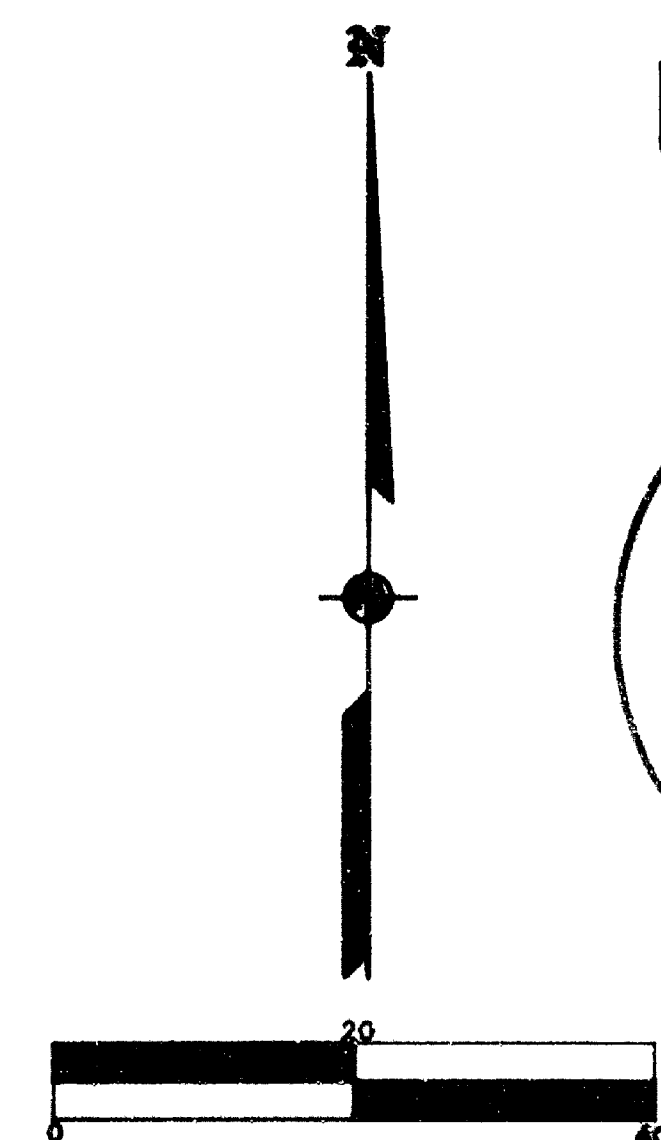

372W11A TL1603