


Arliss C. & Dolores H. Peterson, Prop.

Sec. 11 T38S R2W W.M.

Scale 1" = 60 ft.

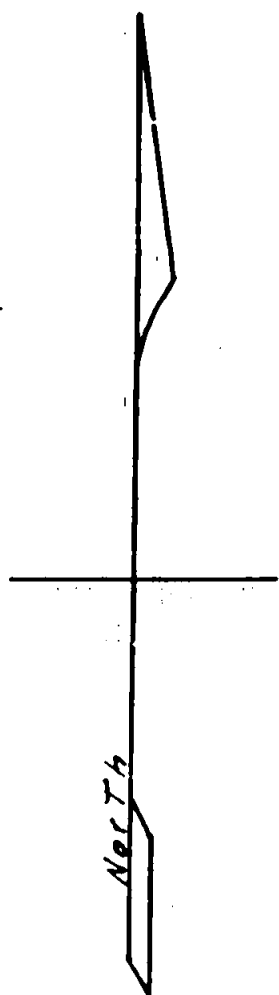

ONE COR.  
D.L.C. NO. 47

577° 19' E

Pioneer Road as Occupied

2626  
572.55' E  
62.05'

568° 52' E  
264.48'

REGISTERED  
OREGON  
LAND SURVEYOR  
*Ralph J. Ellis*  
OCTOBER 4, 1957  
RALPH J. ELLIS  
316

3.85 Acres

N08° 44' E  
563.12'

N0° 10' E

197.08'  
S70° 03' W

96.21'  
S12° 47' E

135.0'  
S09° 04' E

393.07'  
S86° 13' W

RECEIVED  
JACKSON  
MAY 5 1960  
COUNTY  
ENGINEER-SURVEYOR

S.W. COR.  
D.L.C. No. 47

N08° 44' E

114.99'  
N89° 53' W

S.E. COR.  
D.L.C. No. 47  
2" pipe

Iron Pins Mark all corners

Survey Narrative to comply with Paragraph 209.250  
Oregon Revised Statutes

For:

Arliss C. and Dolores A. Peterson

Purpose:

To locate the boundaries of a tract of ground bound on the North by the Right of Way of the Pioneer Road, on the West by a tract of ground owned by Owen Thomas and<sup>a</sup> designated boundary on the East and South by the original owner.

Procedure: I had previously surveyed a tract on the west owned by a Mr. Thomas and had established a line between the S.E. corner of DLC No. 47 and the N.E. corner. I started the survey at the N.W. corner which was the N.E. corner of the Thomas property and followed the right of way of the Pioneer Road as occupied, East to establish the N.E. corner designated by the owner, then followed a designated line South to establish the East line, then ran a straight line to designate the South boundary to an intersection of the East line of the Thomas property, thence North to establish the west line of the property. I also had the south line of DLC No.47 established and made a tie from the S.E. corner of DLC no.47 to the S.W. corner of the property.

