


# MAP OF SURVEY

LOCATED in the SE 1/4 of Section 10,  
T. 34 S., R. 1 W., W.M., Jackson Co., Or.

Date: Sept. 21, 1994

SURVEY FOR: Harry Grant  
Old Ferry Road  
Shady Cove, Oregon

SURVEYED BY: Edwards Surveying & Land Planning, Inc.  
816 West 8th Street  
Medford, Oregon 97501  
Phone: (503) 776-2313

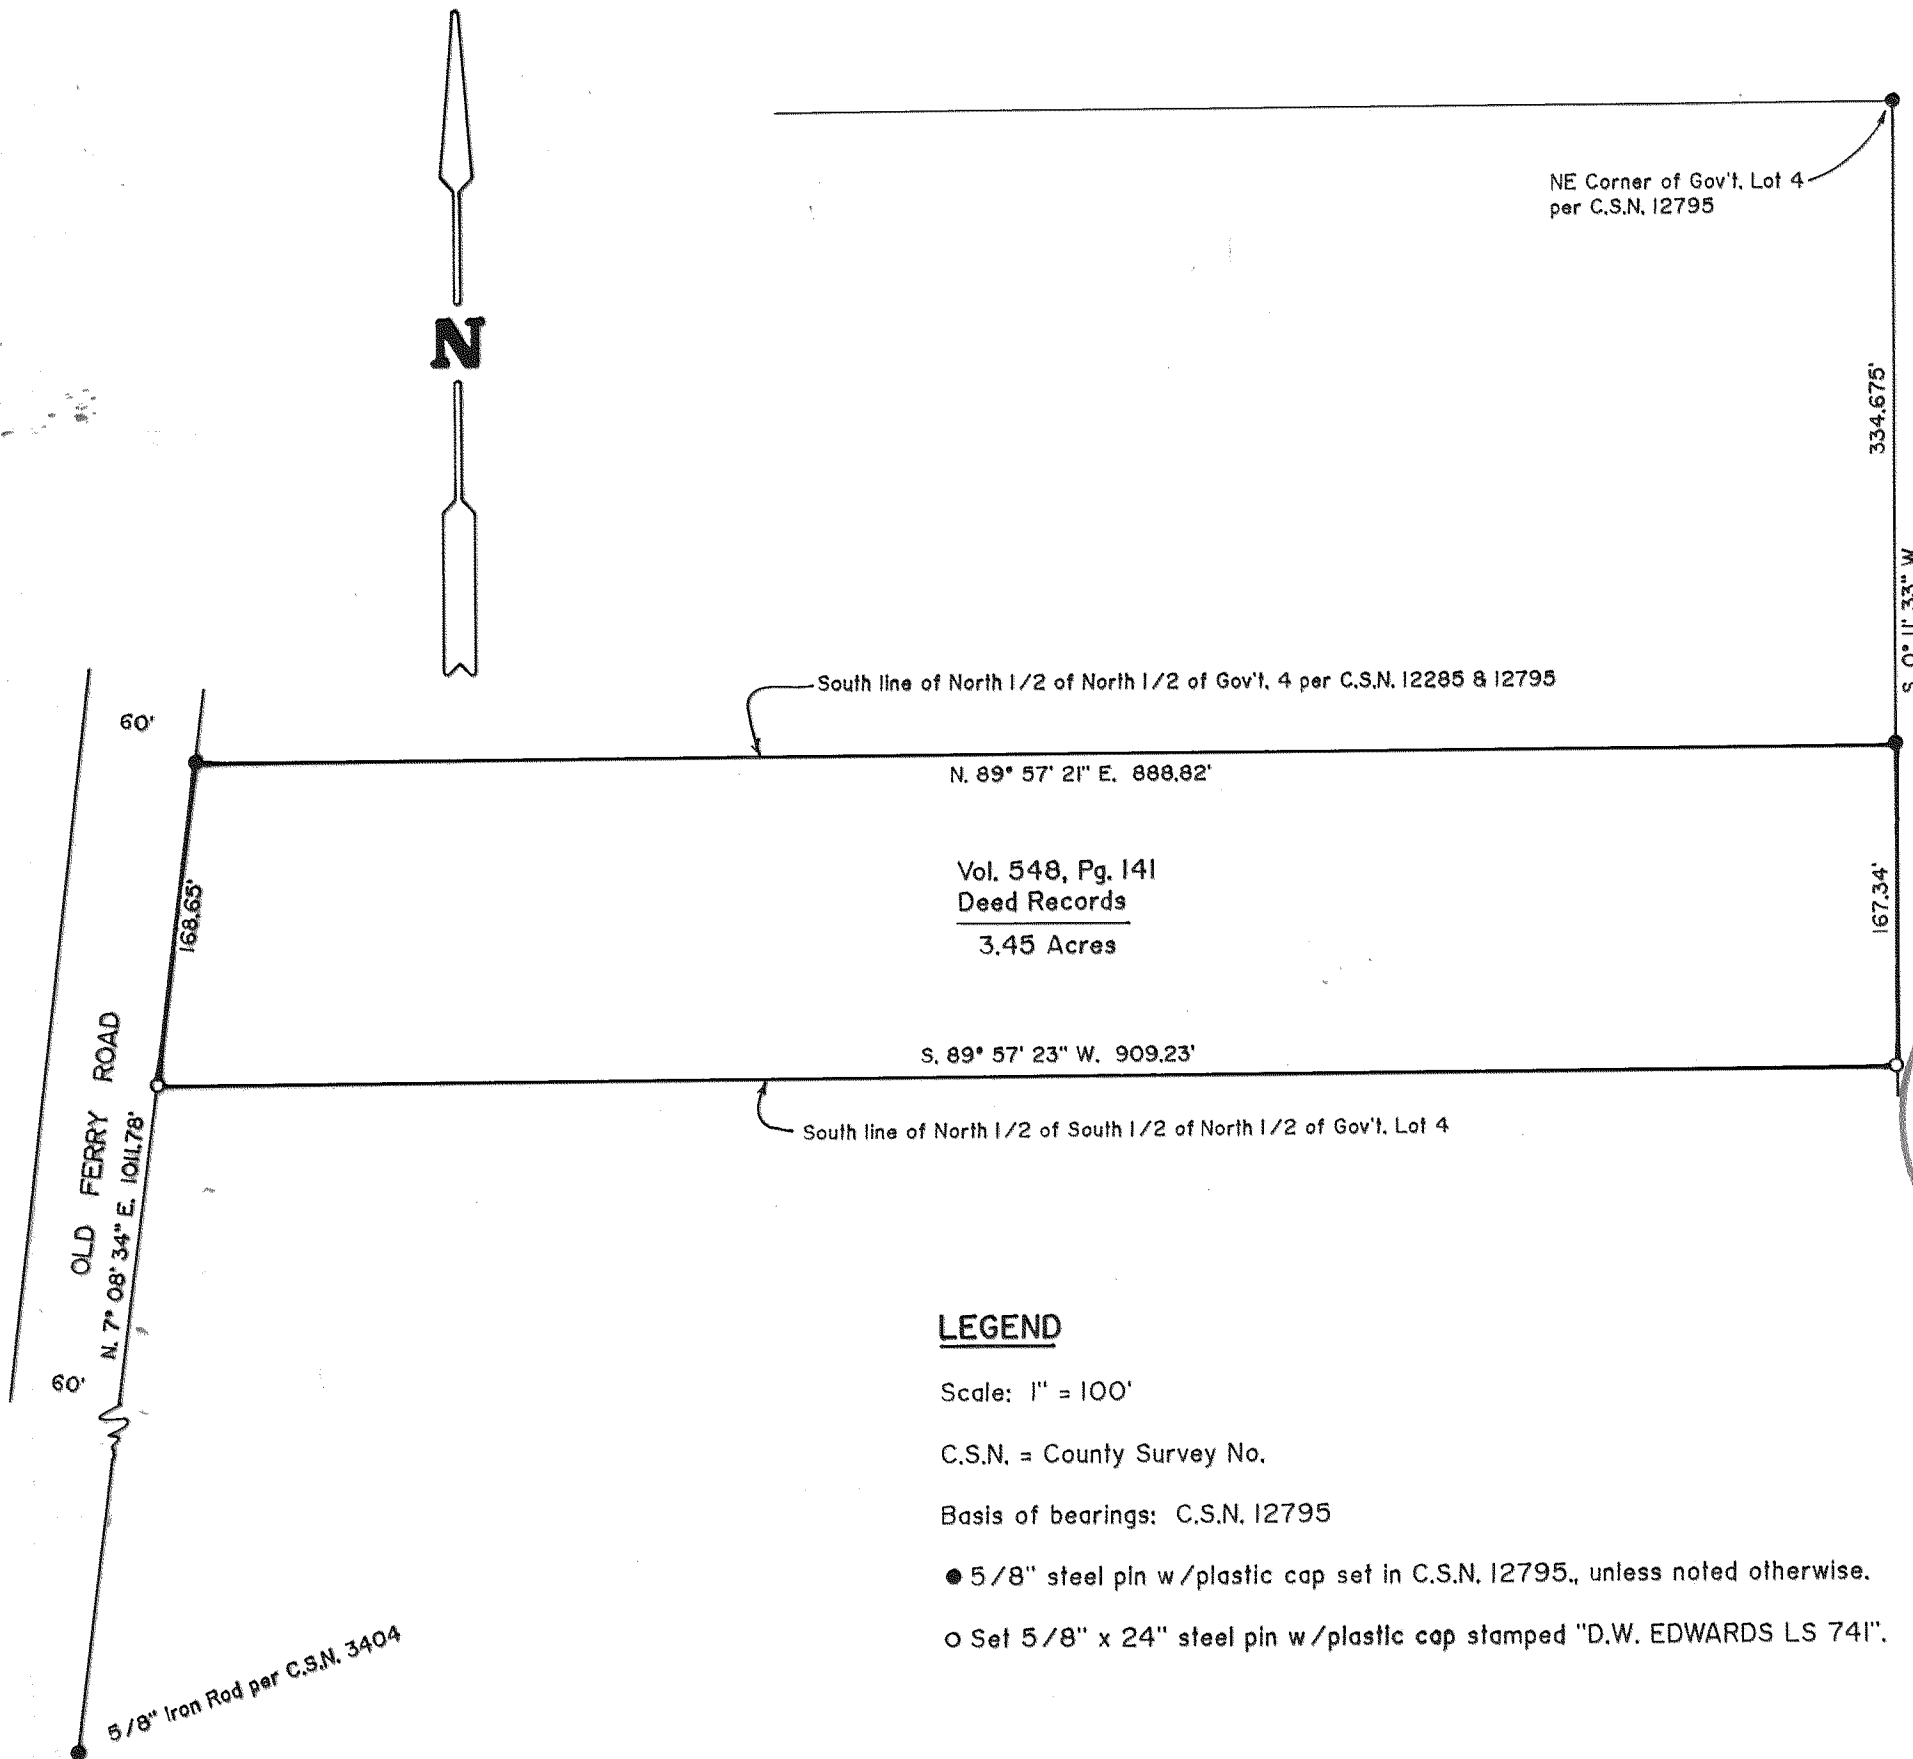

Vol. 548, Pg. 141  
Deed Records  
3.45 Acres

**\*\* RECEIVED \*\***  
 Date 10-3-94 By RF  
 This survey consists of:  
 - 1 sheet(s) Map  
 - 1 page(s) Narrative  
**JACKSON COUNTY SURVEYOR**

**REGISTERED PROFESSIONAL LAND SURVEYOR**  
*Darrel W. Edwards*  
**OREGON**  
**DARREL W. EDWARDS**  
 741  
 Expires 12/31/95

### LEGEND

Scale: 1" = 100'

C.S.N. = County Survey No.

Basis of bearings: C.S.N. 12795

● 5/8" steel pin w/plastic cap set in C.S.N. 12795, unless noted otherwise.

○ Set 5/8" x 24" steel pin w/plastic cap stamped "D.W. EDWARDS LS 741".

# Edwards Surveying & Land Planning Inc.

816 West 8th Street  
Medford, OR 97501  
Tel.: (503) 776-2313  
FAX: (503) 776-9978



223 SW "I" Street  
Grants Pass, OR 97526  
Tel.: (503) 471-7059  
FAX: (503) 471-7809

SURVEYING • ENGINEERING • PLANNING

## 14214

SURVEY NARRATIVE TO COMPLY WITH CHAPTER 209, PARAGRAPH 205  
OREGON REVISED STATUTES

SURVEY FOR: Harry Grant  
Old Ferry Road  
Shady Cove, Oregon

LOCATION: Southeast 1/4 of Section 10, Township 34 South,  
Range 1 West of the Willamette Meridian in  
Jackson County, Oregon.



PURPOSE: To survey and mark the outside boundaries of a  
tract of land described in Volume 548, Page 141,  
Deed Records for Jackson County, Oregon.

PROCEDURE: Used monuments found as shown on accompanying  
MAP OF SURVEY for control. Information taken  
from County Survey No. 12285 and 12795 to  
compute boundary locations. Set two additional  
corners as shown on the accompanying MAP OF  
SURVEY.


EQUIPMENT: Nikon NTD-4 Semi-automatic Theodolite/E.D.M.

BASIS OF BEARINGS: County Survey No. 12795.

DATE COMPLETED: September 21, 1994.

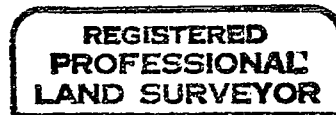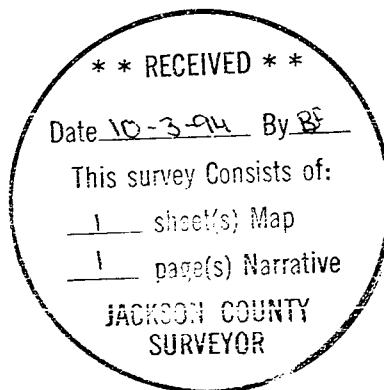

*Darrel W. Edwards*

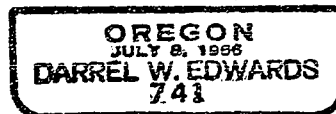

Expires 12/31/95