


1422

Survey For
WALTER VILAS
Located in Sec. 16, T. 37 S., R. 1 W., W.M.
By: Mark E. Boyden
April, 1960


SCALE: 1"=100'
• Set 5/8" iron pin

REGISTERED
OREGON
AND SURVEYOR
Mark E. Boyden
NOVEMBER 9 1961
MARK E. BOYDEN

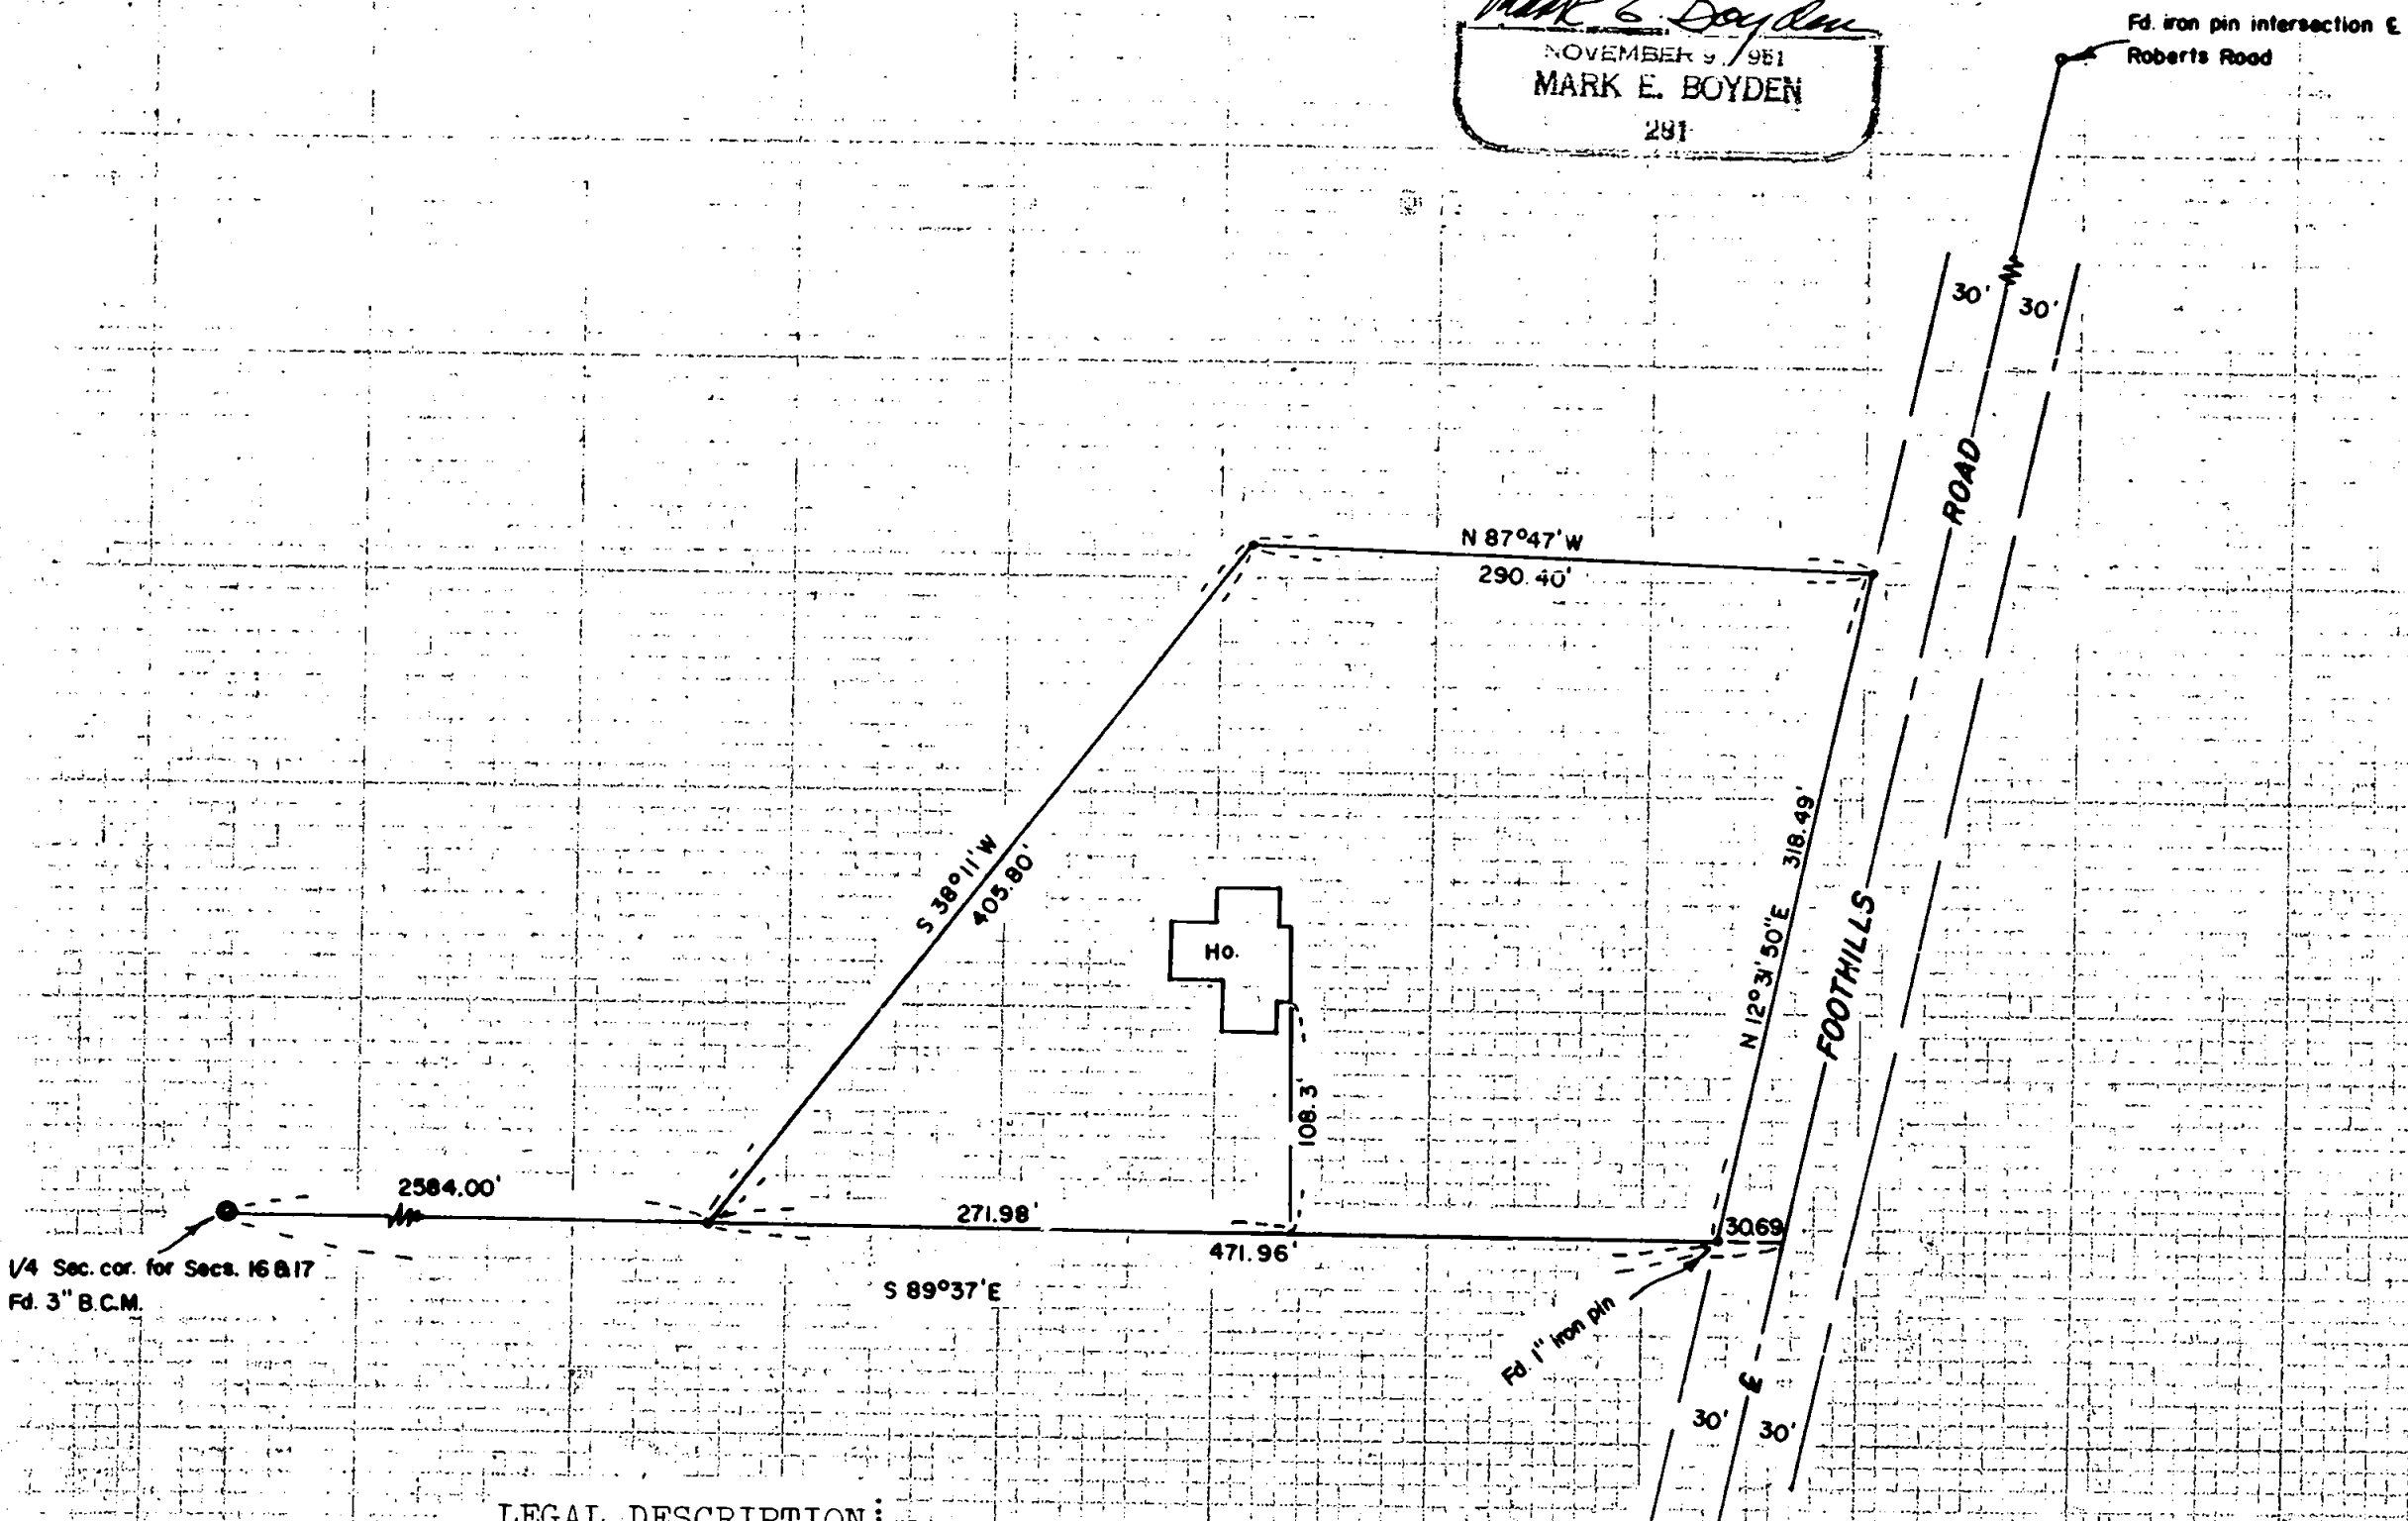

LEGAL DESCRIPTION:
Beginning at a point on the North boundary of Stewart Acres in Jackson County, Oregon, from which point the quarter corner between Sections 16 and 17, Township 37 South, Range 1 West of the Willamette Meridian in Jackson County, Oregon, bears North 86° 36' West, 2584.0 feet; and from said point of beginning run thence along said North line of Stewart Acres, South 89° 36' East, 473.7 feet;
thence North 12° 26' East, 318.32 feet;
thence North 87° 46' West, 291.48 feet to a point at the Southwest corner of tract of land described in Volume 299, Page 77, Deed Records of Jackson County, Ore.
thence South 38° 08' West 405.78 feet, more or less to the point of beginning.

I hereby certify that I have measured the location of the improvements shown hereon with respect to the property lines, and find that there are no encroachments or overlaps on the adjacent properties.

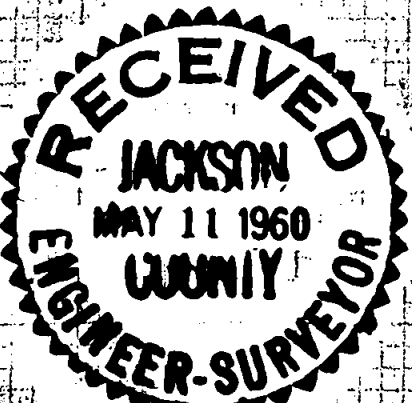

Mark E. Boyden
Surveyor

1422

SURVEY NARRATIVE TO COMPLY WITH PARAGRAPH 209.250
Oregon Revised Statutes

FOR: WALTER VILAS

PURPOSE: To monument and certify the improvements on that property described in Voume 319, Page 165 of the Deed Records of Jackson County, Oregon, being located in Section 16, Township 37 South, Range 1 West.


PROCEDURE:

On the location survey for Foothills Road, the East and West centerline of Section 16 was traversed and iron pins were set on the intersection of said centerline with the right-of-way lines of Foothill Road (see County road notes)

From said basic information, the boundaries of the Vilas Tract were computed according to the Deed description, said property being "cut-off" to the West boundary of Foothills Road.

Monumented the parcel as shown, using said County Road Survey Solar Meridian for bearing control.

April 1960

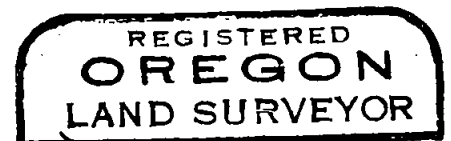

Mark E. Boyden
NOVEMBER 9, 1951
MARK E. BOYDEN
281

