


14240

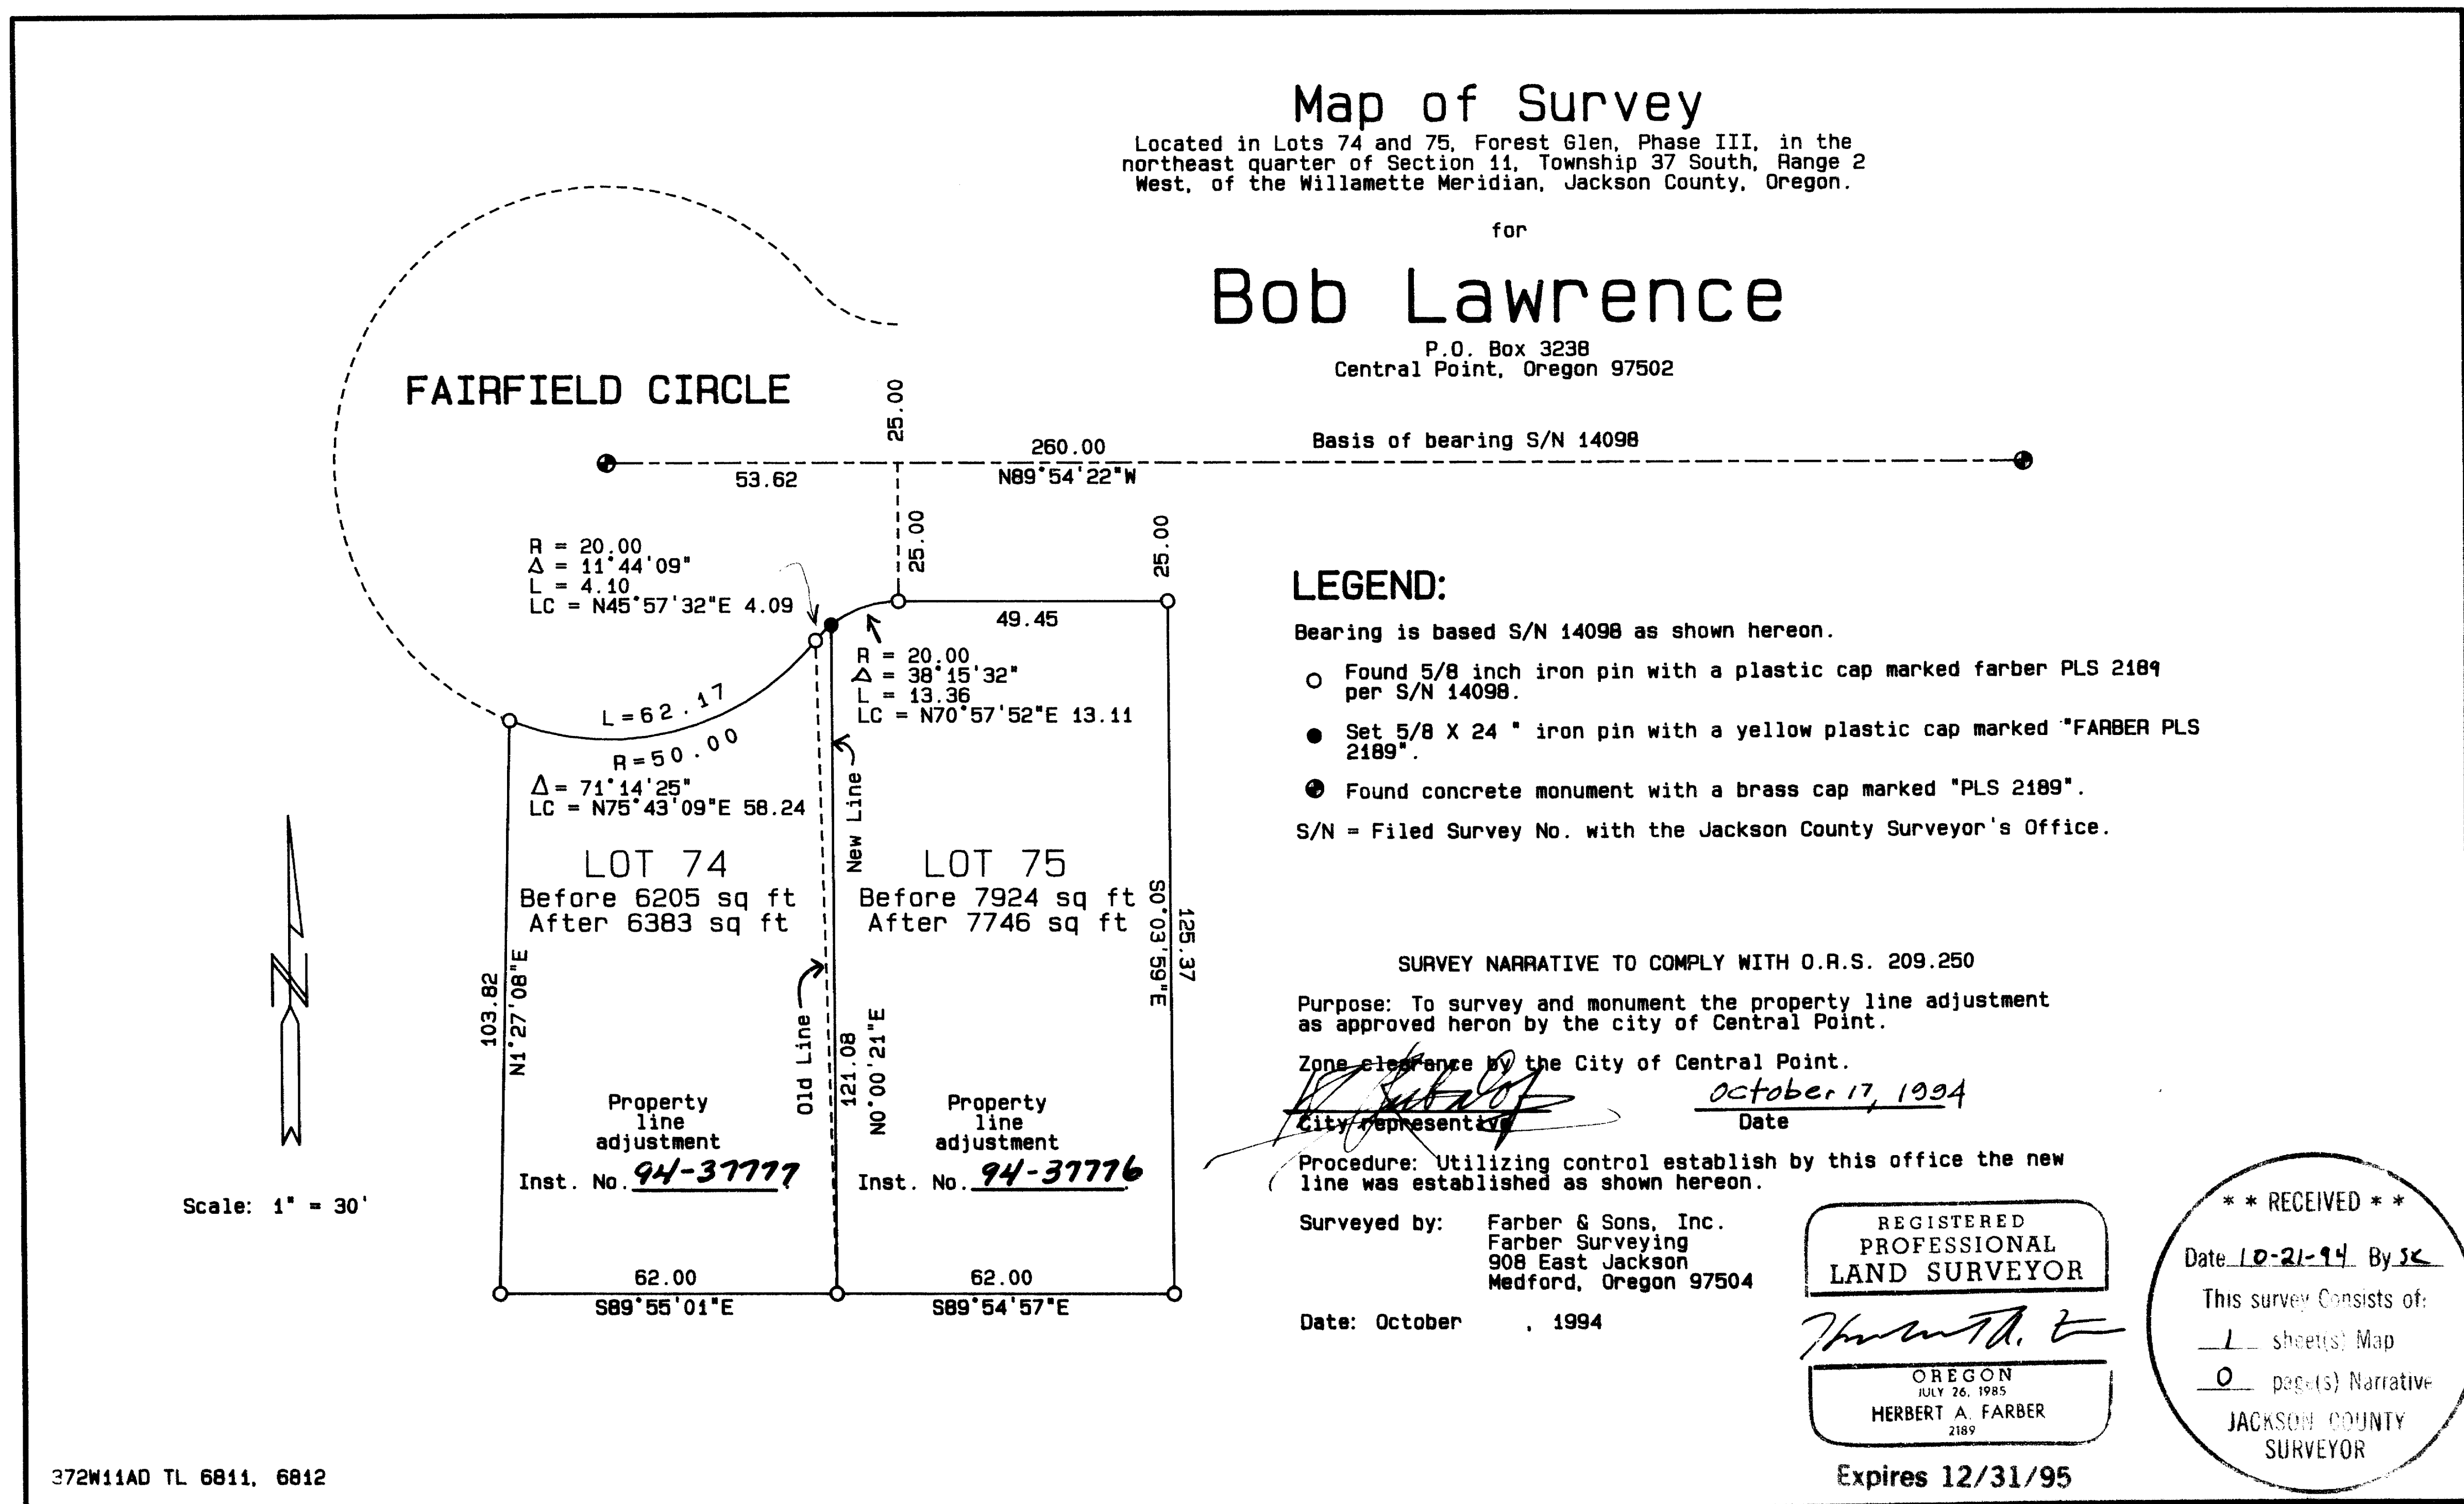

14240