


1428

1428

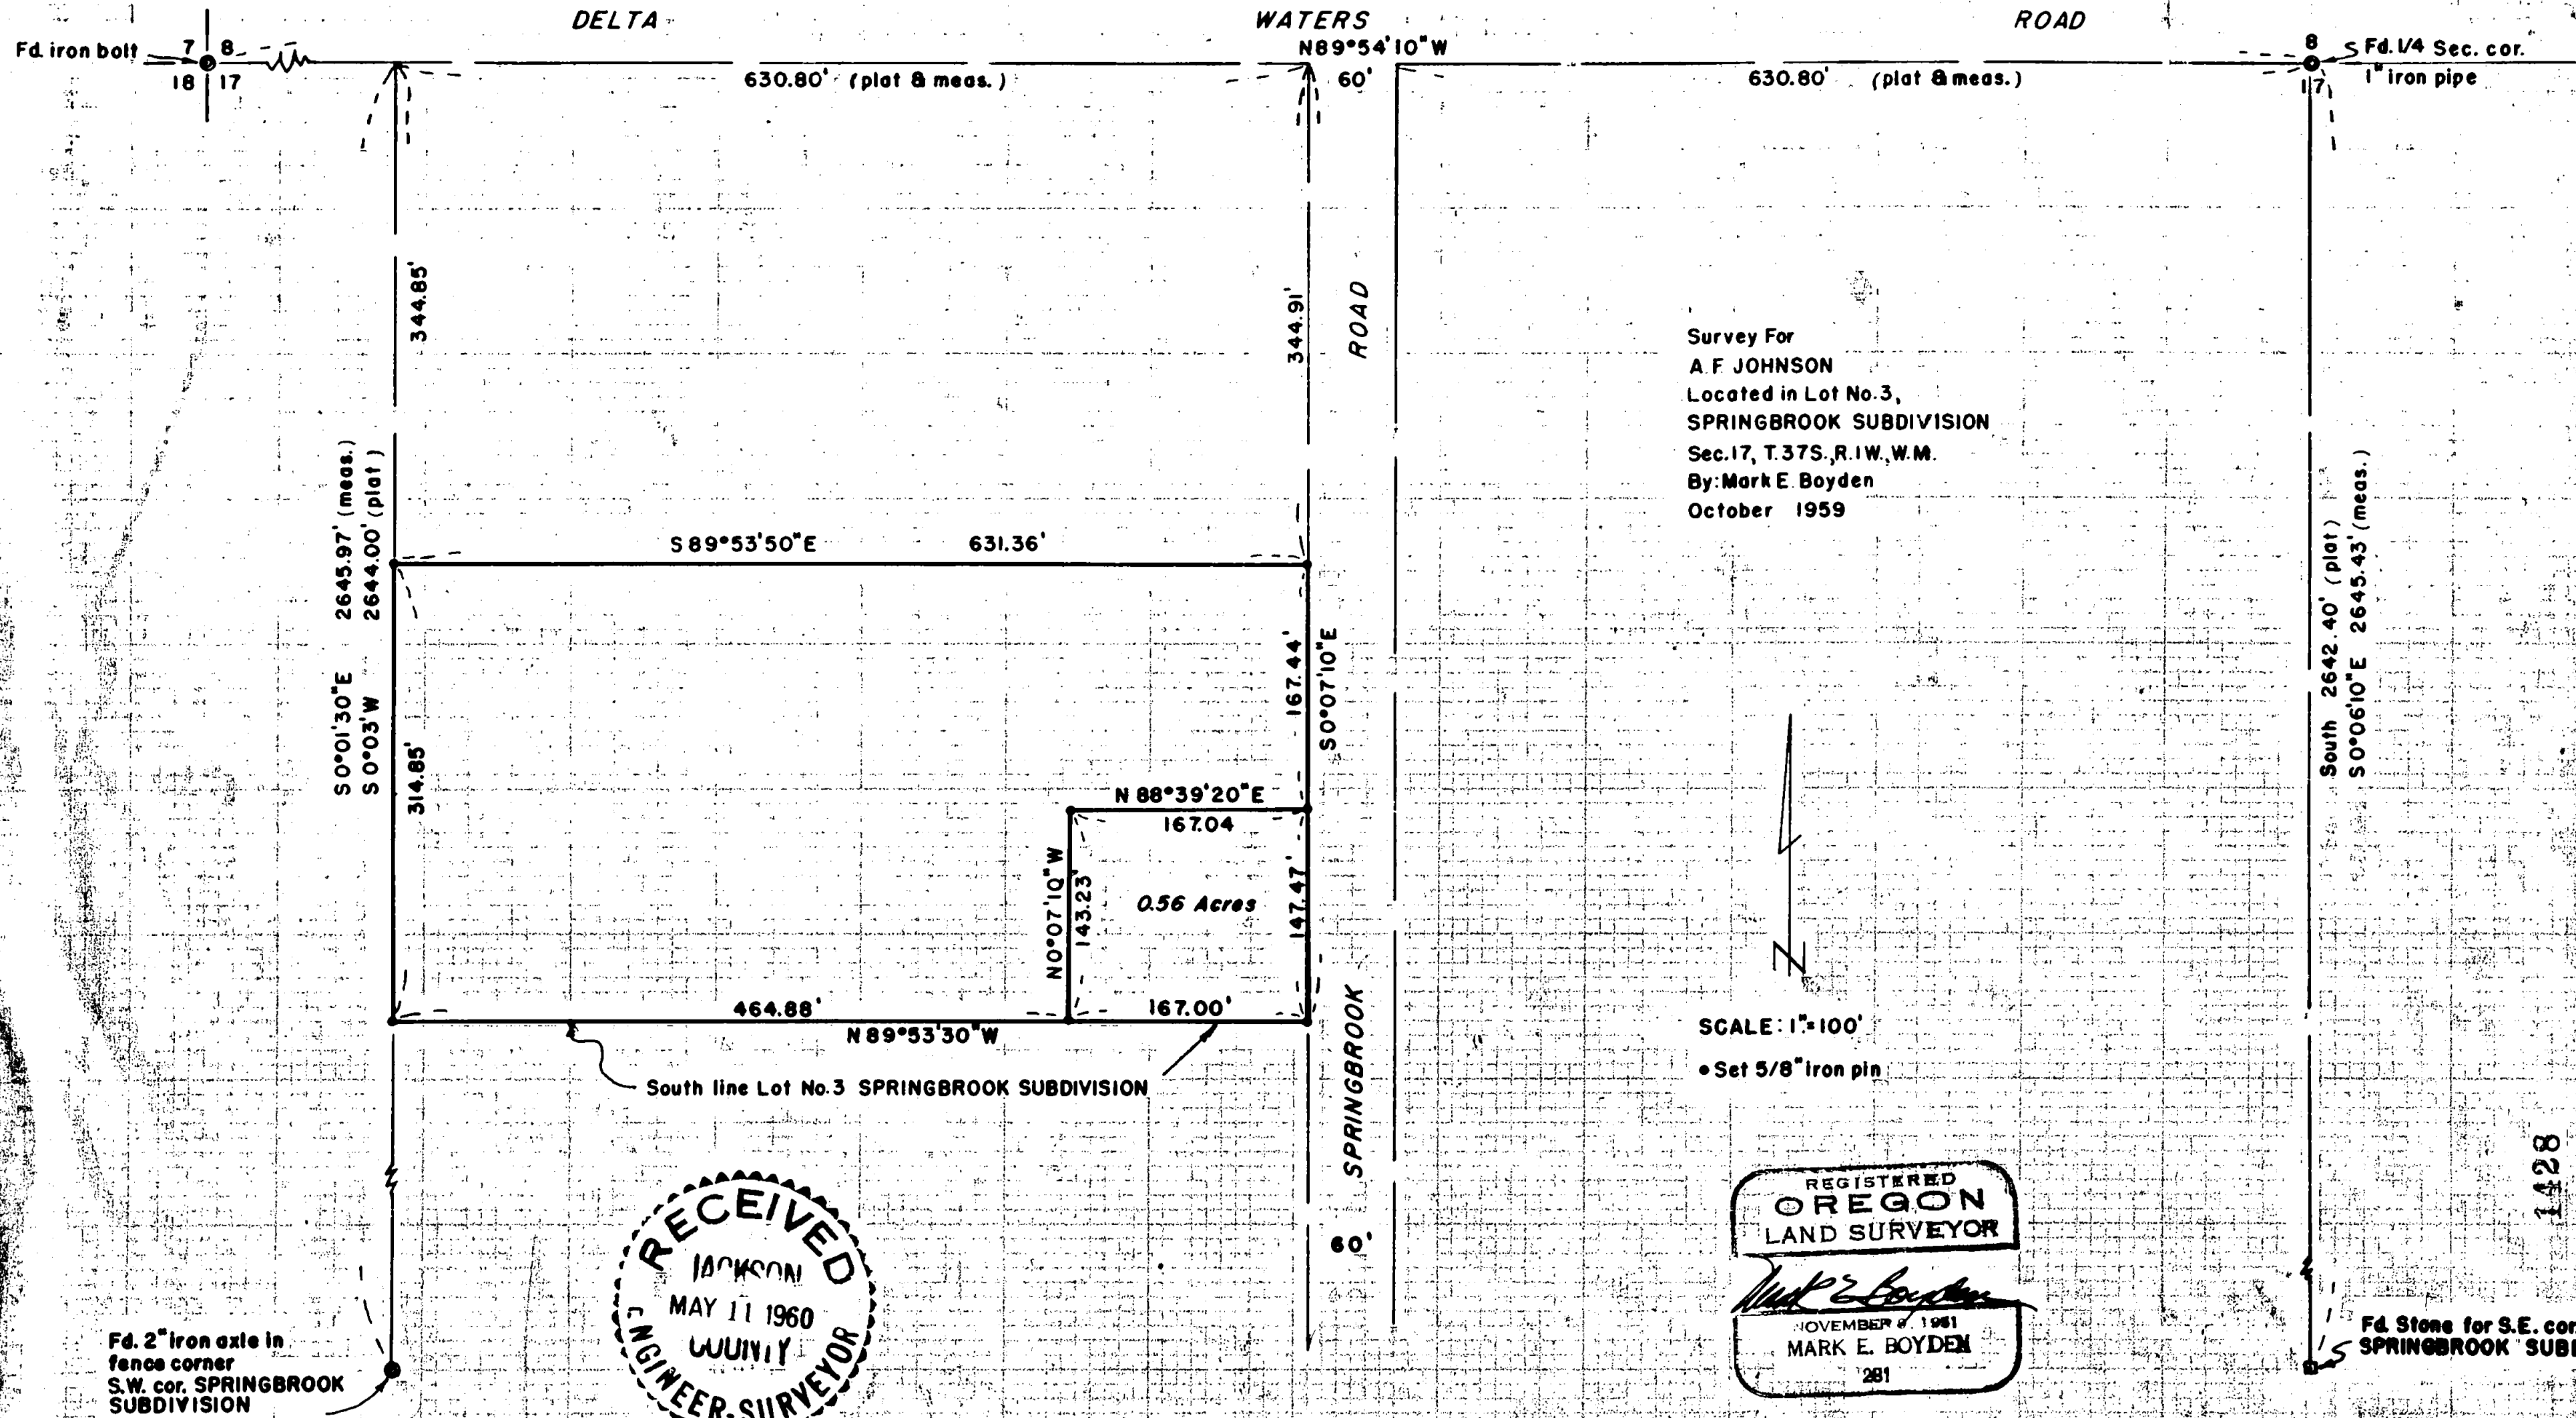

Survey For  
 A F JOHNSON  
 Located in Lot No. 3,  
 SPRINGBROOK SUBDIVISION  
 Sec. 17, T. 37S., R. 1W., W.M.  
 By: Mark E. Boyden  
 October 1959

SCALE: 1"=100'  
 • Set 5/8" Iron pin

REGISTERED  
 OREGON  
 LAND SURVEYOR  
 NOVEMBER 7, 1961  
 MARK E. BOYDEN  
 281

RECEIVED  
 MAY 11 1960  
 ENGINEER-SURVEYOR

Fd. 2" iron axle in  
 fence corner  
 S.W. cor. SPRINGBROOK  
 SUBDIVISION

Fd. Stone for S.E. cor.  
 SPRINGBROOK SUBD.

1428

1428

Survey Narrative to Comply With Paragraph 209.250  
Oregon Revised Statutes

FOR: A. F. Johnson

- PURPOSE: 1. To monument the outside boundaries of the Johnson property, being all of Lot No. 3 of SPRINGBROOK SUBDIVISION, except the North 15 feet.
2. To monument and describe the residence tract.

PROCEDURE:

Ran a closed traverse around the outside boundaries of SPRINGBROOK SUBDIVISION, finding monuments for the North-east, Southeast and Southwest corners of said Subdivision. Established the Northwest corner of said Subdivision on the North boundary of Section 17 and plat record distance Westerly from the 1/4 corner to Sections 8 and 17. From this information, proportioned in the Lot boundaries and Springbrook Road as shown, setting 5/8" iron pins at all property corners.

October 1959

