
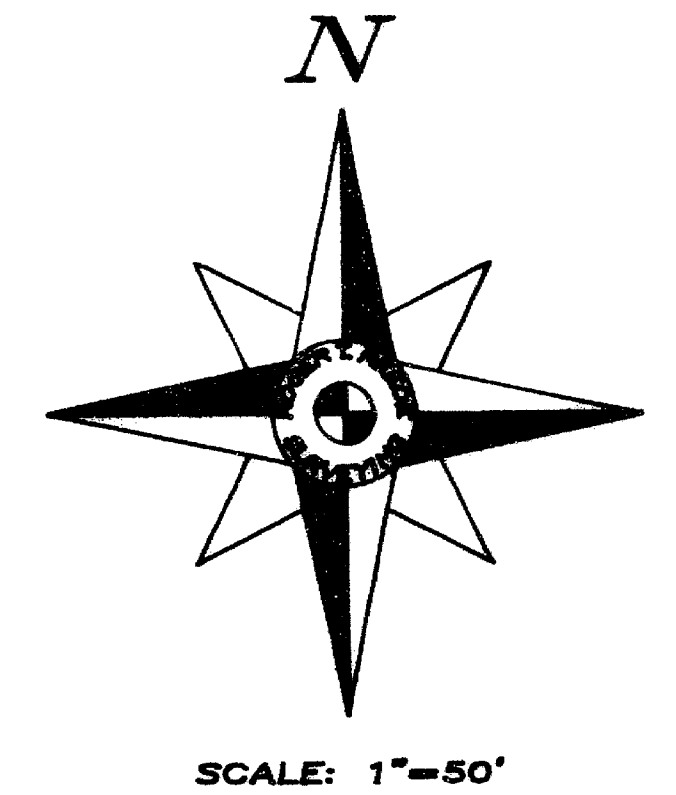


14316

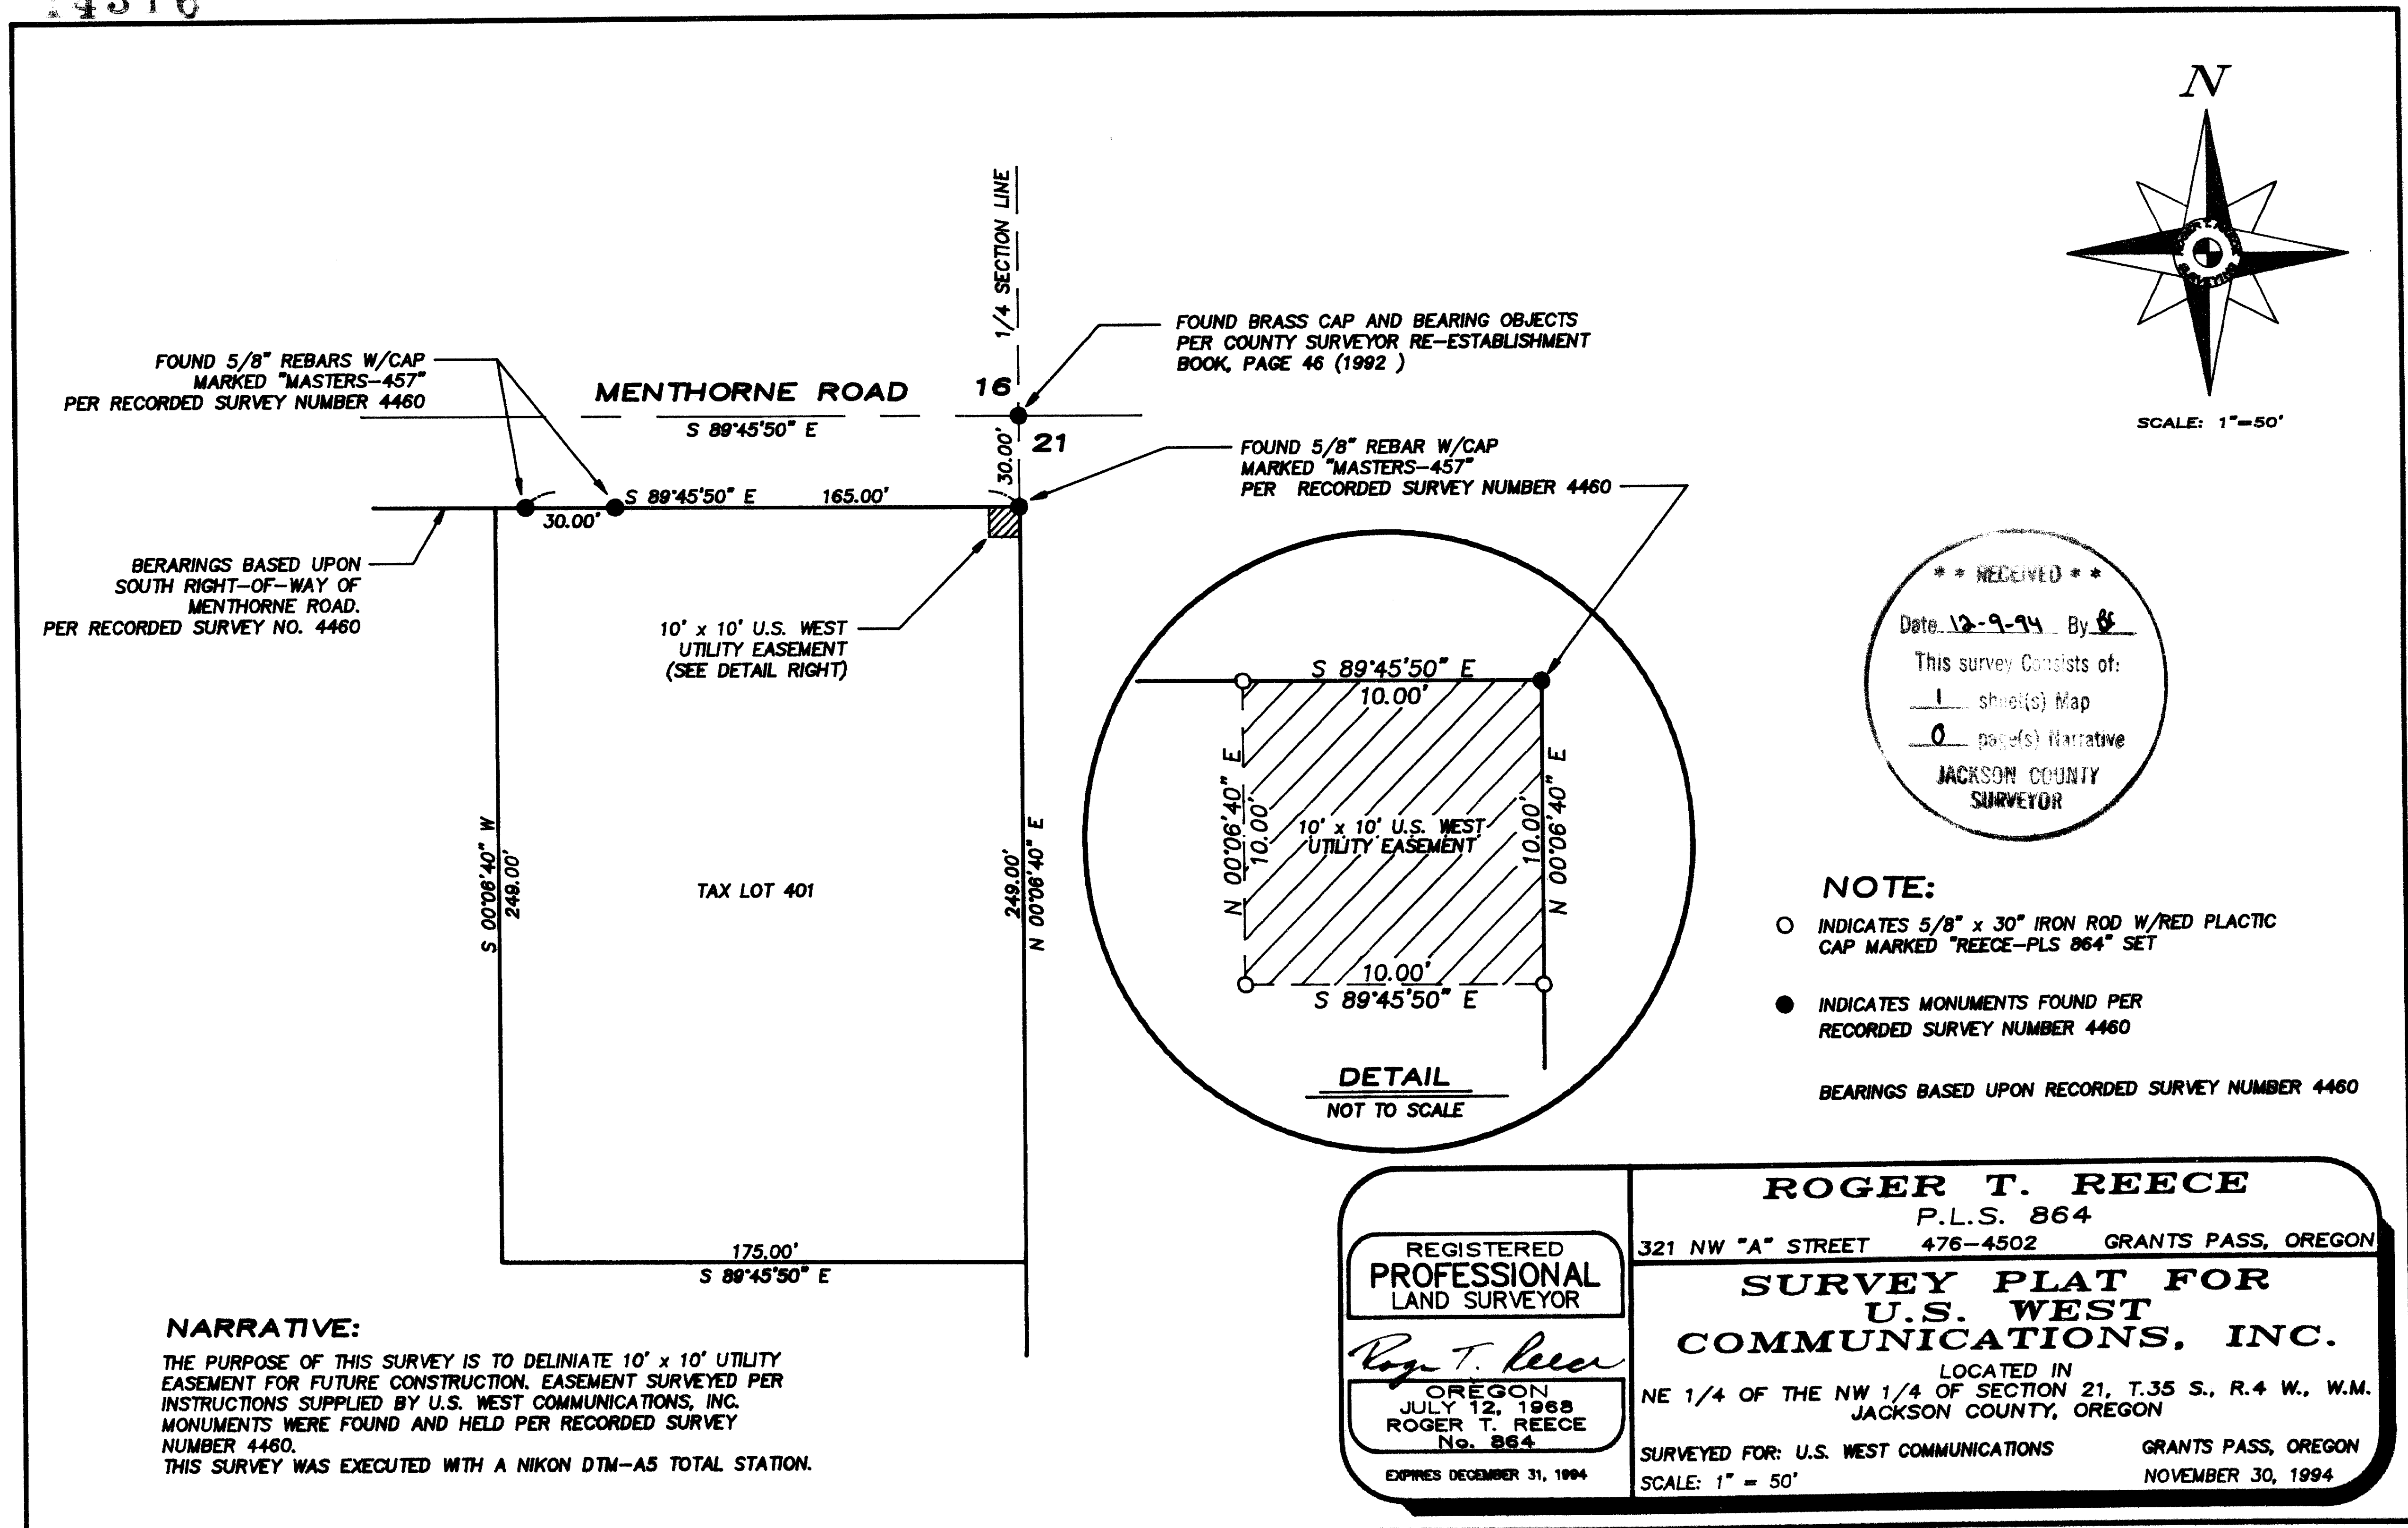

**\*\* RECEIVED \*\***  
Date 12-9-94 By 8  
This survey consists of:  
1 sheet(s) Map  
0 page(s) Narrative  
**JACKSON COUNTY SURVEYOR**

14316