

RICHARD G. TEMPLIN
PROFESSIONAL LAND SURVEYOR
100 Poorman Creek Road
Jacksonville, Oregon 97530
Phone/Fax: (503) 899-2032 • 474-7720

At the CS 1/16th corner,

I set:

A 5/8" rebar with a yellow plastic cap marked "TEMPLIN LS 2359 ", from which the following bearing trees:

A Black Oak, 12" diameter bears S 4 1/4°E, 32.8 feet, scribed "CS1/16" "BT".

A White Oak, 12" diameter bears West, 12.70 feet, scribed "CS1/16" "BT".

At the SE 1/16th corner,


I set:

A 5/8" rebar with a yellow plastic cap marked "TEMPLIN LS 2359 ", from which the following bearing trees:

A White Oak, 11" diameter bears S 19 3/4°E, 4.0 feet, scribed "SE 1/16" "BT".

A White Oak, 11" diameter bears N 75°W, 8.8 feet, scribed "SE 1/16" "BT".

All bearing trees scribed, painted flo-red and tagged with "BT" signs.

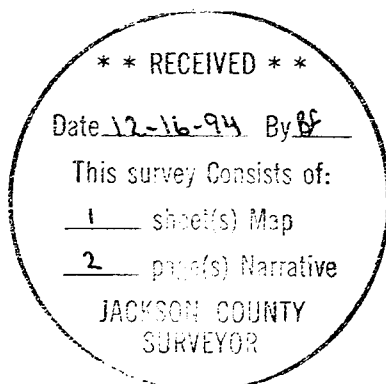

RICHARD G. TEMPLIN
PROFESSIONAL LAND SURVEYOR
100 Poorman Creek Road
Jacksonville, Oregon 97530
Phone/Fax: (503) 899-2032 • 474-7720

14321

NARRATIVE

Survey No. _____

SURVEY FOR: Boise Cascade Corp.
P.O. Box 100
Medford, Or. 97501

LOCATION: In Section 32, Township 34 South, Range 2 West,
of the Willamette Meridian, Jackson County,
Oregon.

PURPOSE: To survey and mark those certain lines as
requested by my client, shown on accompanying
map.

DATE: December 15, 1994

BASIS OF BEARINGS: Bearings based upon Filed Survey number 14222,
the South line of the of Section 29.

PROCEDURE: From previous set control, I tied the SW
an SE corners of Section 32, along with the, S
1/4 and W 1/4 corners. I computed the Section
breakdown, as shown. At the SW 1/16th corner,

I set:

A 5/8" rebar with a yellow plastic cap marked
"TEMPLIN LS 2359 ", from which the following
bearing trees:

A Douglas Fir, 8" diameter, bears N 89° W, 46.4
feet, scribed "SW1/16" "BT".

A Black Oak, 9" diameter bears N 47 3/4°W, 37.3
feet, scribed "SW 1/16" "BT".

At the CW 1/16th corner,

I set:

A 5/8" rebar with a yellow plastic cap marked
"TEMPLIN LS 2359 ", from which the following
bearing trees:

A Black Oak, 8" diameter bears N 73 1/2°E, 17.0
feet, scribed "CW 1/16" "BT".

A White Oak, 32" diameter bears S 37 1/4°E, 22.6
feet, scribed "CW 1/16" "BT".