# MAP OF SURVEY
FOR
# DON PETTIT
416 S. ROYAL
EAGLE POINT, OREGON
LOCATED IN
SE1/4 SECTION 9, T38S, R1W, W.M.
CITY OF PHOENIX, JACKSON CO., OREGON

LEGEND:
FS = FILED SURVEY
⊕= 5/8"PIN/CAP #6599
⊙= 3/4"PIPE
⊘= 5/8"PIN/CAP #FS9251
●= SET 5/8"X24"PIN/CAP #2189

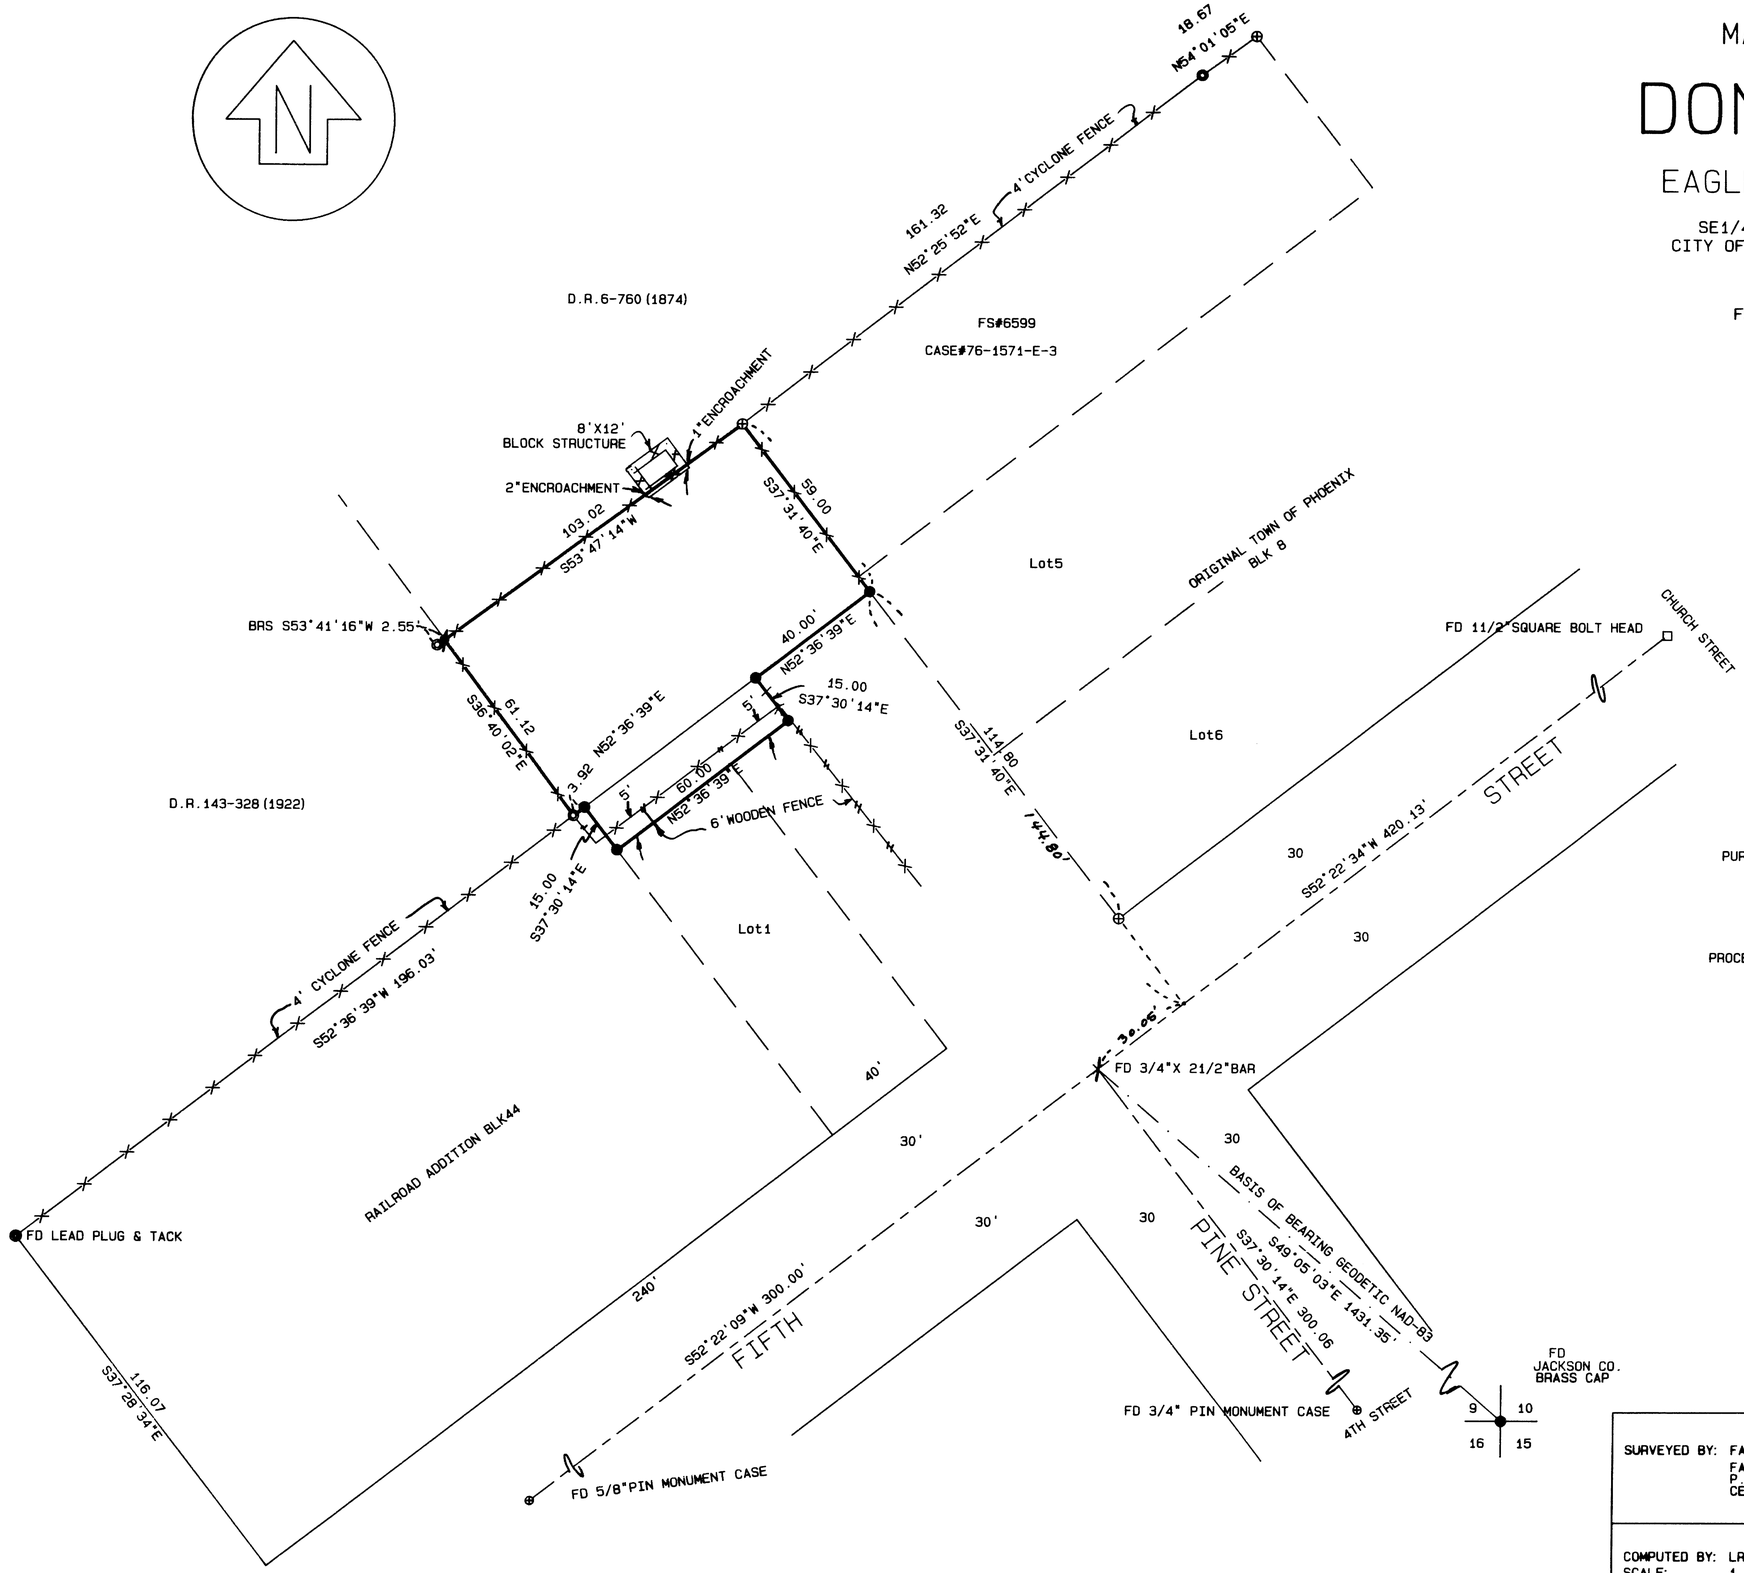


PURPOSE:
SURVEY NARRATIVE TO COMPLY WITH ORS 209-250
TO MONUMENT A PARCEL OF LAND, AS SHOWN.
DOCUMENTS THAT WERE USED TO DETERMINE
SAID PARCEL BOUNDARY; 90-17648,
CASE #94-3283-E-2, 93-23297.

PROCEDURE:
AFTER RECOVERING ALL AVAILABLE DEED CORNERS
AND ADDITIONAL CONTROL MONUMENTS
A SURVEY TO THESE CORNERS WAS MADE.
THE MISSING DEED CORNERS WERE CALCULATED
AND SET, AS SHOWN ON THE ACCOMPANYING MAP.
GPS OBSERVATIONS WERE TAKEN TO
ESTABLISH CONTROL AND BASIS OF BEARING

* * RECEIVED * *
Date 2-21-95 By JK
This survey Consists of:
1 sheet(s) Map
0 page(s) Narrative
JACKSON COUNTY SURVEYOR

REGISTERED
PROFESSIONAL
LAND SURVEYOR
OREGON
JULY 26, 1985
HERBERT A. FARBER
2189
Expires 12/31/95

SURVEYED BY: FARBER & SONS, INC.
FARBER SURVEYING
P.O. BOX 5286
CENTRAL POINT, OREGON 97502

OFFICE:
908 EAST JACKSON
MEDFORD, OREGON 97504
PHONE: (503) 776-0846

COMPUTED BY: LRS
SCALE: 1 inch : 30 feet
DATE: 21 FEB 1995

ROTATION: 0°
ORIGIN: 9840.000 N 19685.000 E
JOB No.: 471-95

38-1W-S9D-TL3000