

E. NINTH ST.

RIVERSIDE AVE.

89° 56' 15"

00.00

00.00

30.00

SURVEY IN BROBACK RESERVE

TRACT A & B

FOR

ANTHONY J. BOITANO

60-25

BY EDWARD MCGINTY
MEDFORD, OREGON
APRIL, 1960

SCALE: 1" = 20'
O = 1/2" I. PIN
© - CITY MON.

8.30

200.00

S-CENTRAL

6.00

14.30

1/2" I. PIN FD.

89° 56' 15"

69.30'

52.00'

DEED RECORD

3.00

TRACT B

30.00'

30.00'

1.00

108.00

89° 56' 15"

52.00'

50.00'

16.30'

0.30'

DEED RECORD

3.00

TRACT A

42.00'

42.00'

30.00

89° 56' 15"

50.00'

53.00'

16.00'

REGISTERED
OREGON
LAND SURVEYOR

Edward A. McGinty
JULY 18, 1953
EDWARD A. MCGINTY
301

E. 12TH ST.

JACKSON COUNTY
ENGINEER-SURVEYOR
MAY 12 1960

Survey No. _____


Survey Narrative to comply with O.R.S. 209-120 and O.R.S. 209-205.

Survey for: Anthony J. Boitano and Stan ParrishSurvey by: Edward A. McGinty, L.S.
5/6/60

Determined the center line of east 9th St. from monuments found on Riverside Ave. and Central Ave. Also found monuments on the center line of Central Ave. and East 12th St.

Surveyed tracts A & B from descriptions furnished by client, running division lines parallel to 9th St. and Central Ave.

Found monuments as shown as indicated on North line of Tract B, as indicated on Survey No. 441. Tract B extends 3 ft. east of the east line of the alley. Tract A leaves a 3 ft. vacancy to the west line of the alley as shown.

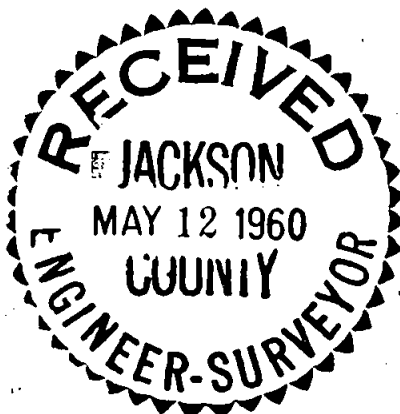

Edward A. McGinty

