## MAP OF SURVEY A portion of the S.W. 1/4 of the S.W. 1/4 of Sec. 31, T.36 S., R.1 W., W.M. Jackson County, Oregon

SURVEY FOR:

B.G. Swanson c/o Prudential Realty 409 East Barnett Medford. OR 97504 SURVEY BY:

L.J. Friar & Associates. P.C. Consulting Land Surveyors 304 South Holly Street Medford. Oregon 97501 Phone: (503) 772-2782

LEGEND:

● - Found County Surveyor's re-established monument and accessories.

• Found 5/8" iron pin per RS2986.

• Found 5/8" iron pin w/ plastic cap mkd. FRIAR PLS961 per RS 11754.

• Set 5/8" x 24" iron pin with plastic cap mkd. L.J. FRIAR & ASSOCIATES.

( ) - Record data as shown.

RS - Recorded Survey #.

BASIS OF BEARINGS: West line of Section 6 per RS9181.

UNIT OF MEASUREMENT: Feet

DATE: January 11. 1995

SCALE: 1"- 100 '


SURVEY NARRATIVE TO COMPLY WITH O.R.S. 209.250


PURPOSE:


To monument the exterior of the clients tracts.

PROCEDURE:

Tied to monuments set by Survey Nos. 2986. and 11153. Calculated the position of the missing corners and set same. During this Survey it was discovered that the 5/8 pin at the S.E. corner of the tract as shown on RS12754 was not on the R/W of Vilas Road. Therefore this corner as well as the pin set on the R/W by RS12754 will serve as witness corners and were not used to determine the position of the R/W on this Survey. Those monuments found as well as those set are as shown hereon.

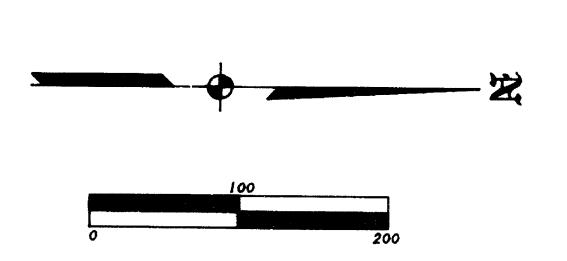

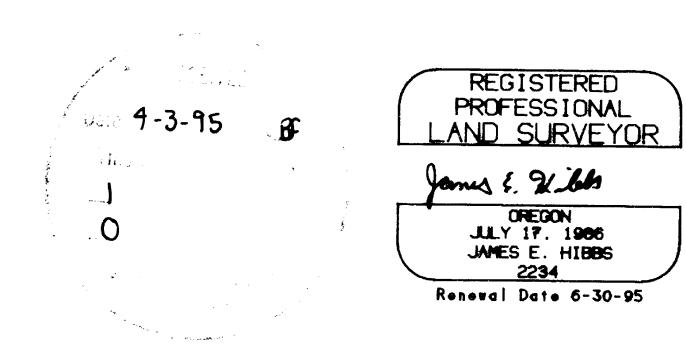

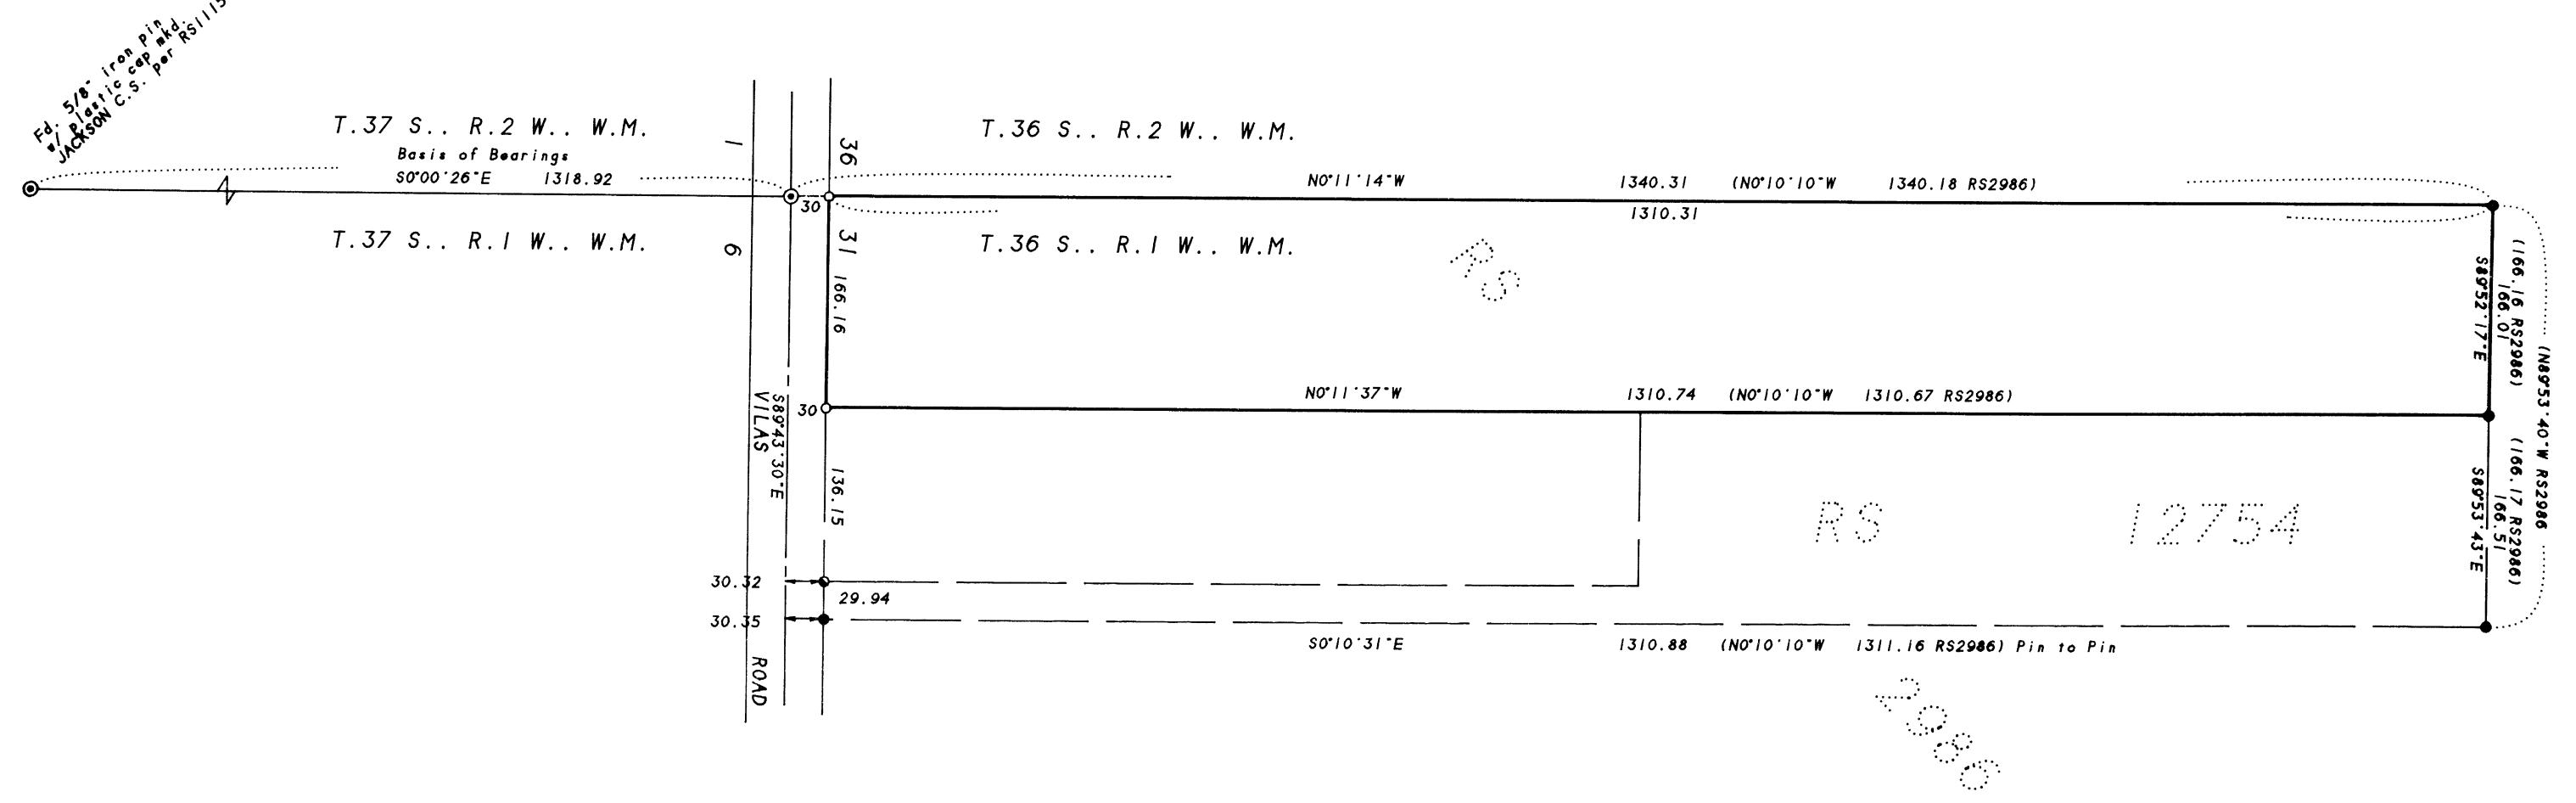

361W31C TL'S 4700 & 4800

SCALE: I Inch : 100 foot

Rotation: 90

350.000 N 5550.000 E