

REGISTERED
OREGON
LAND SURVEYOR


Leland P. Lovejoy

NOVEMBER 18, 1949
LELAND P. LOVEJOY
262

**BOUNDARY SURVEY
SITUATED IN**

D.L.C. NO. 84, T. 37S., R. 2W., W. M.
JACKSON COUNTY, OREGON
FOR
DOUGLAS OIL CO. OF CALIFORNIA
L.P. LOVEJOY, L.S. MEDFORD, ORE.
SCALE: 1" = 100'

NOTE: NO VISIBLE EVIDENCE
OF ANY IRRIGATION DITCHES
OR LATERALS EXISTING WITH-
IN BOUNDARIES OF THIS PROPERTY.

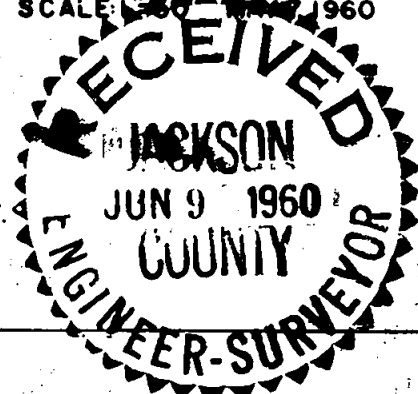

Survey Narrative to Comply with Section 87-330

1947 Oregon State Laws

Survey For: Douglas Oil Co. of California
Paramount, California

Purpose of Survey: To establish property boundaries

Survey Location: D. L. C. 84, Township 37 South,
Range 2 West, Willamette Meridian,
Jackson County, Oregon.

Survey Procedure: Found D. L. C. corners as shown on
map. Ran out property description
and set 3/4" G. I. pipe with lead plugs
and copper tacks.

Leland P. Lovejoy
Registered Land Surveyor

Work completed May 7, 1960

