

Edwards Surveying & Land Planning Inc.

816 West 8th Street
Medford, OR 97501
Tel.: (503) 776-2313
FAX: (503) 776-9978



598 NE "E" Street, Suite B
Grants Pass, OR 97526
Tel.: (503) 471-7059
FAX: (503) 471-7809

SURVEYING • ENGINEERING • PLANNING

SURVEY NUMBER 14545

SURVEY NARRATIVE TO COMPLY WITH CHAPTER 209, PARAGRAPH 250, OREGON REVISED STATUTES

SURVEY FOR: Bill and Diana Readance
1024 Mira Mar Avenue
Medford, Oregon 97501

LOCATION: In Lots 4 and 5, Block 3, of MONT CREST
SUBDIVISION-UNIT NO. 1, in the SW 1/4 of
Section 33, T. 37 S., R. 1 W., W.M.,
City of Medford, Jackson County, Oregon.



PURPOSE: PROPERTY LINE ADJUSTMENT; To locate and
monument the adjusted boundary between tax lots
400 and 500 and to prepare new legal
descriptions for each adjusted tract.

PROCEDURE: Utilizing found monuments per the recorded plat
of MONT CREST SUBDIVISION-UNIT NO. 1 for
control as shown, computed the proration of
each lot. Monuments set on this survey consist
of 5/8" x 24" steel pins with red plastic caps
mkd. "D.A. EDWARDS-LS 2339".

**BASIS OF
BEARINGS:** Plat of MONT CREST SUBD.-UNIT NO. 1.

EQUIPMENT: Nikon DTM-A5 Electronic Total Station.

**DATE
COMPLETED:** May 25, 1995.

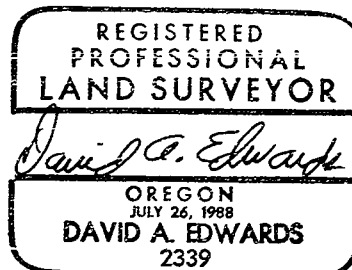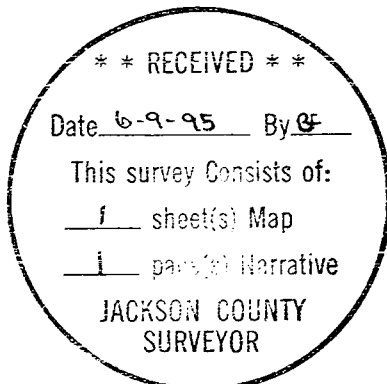

Expires 12/31/95