

SCALE: 1"=200'

SURVEY NARRATIVE

PURPOSE: To survey and mark the adjusted corners, per Jackson County Staff report 94-86 LLA, as depicted on the map.

PROCEDURE: From previous set control set on filed survey number 13494, I computed adjusted positions and set, as shown.

LEGEND

- SET 5/8" X 30" REBAR WITH YELLOW PLASTIC CAP MARKED "TEMPLIN LS2359"
- FOUND 5/8" X 30" REBAR WITH YELLOW PLASTIC CAP MARKED "TEMPLIN LS2359", PER FILED SURVEY NUMBER 13494.
- ⊕ FD. BRASS CAP IN MON. CASE PER JACKSON COUNTY REESTABLISHMENT BOOK PAGE 76
- ⊞ FD. BRASS CAP MONUMENT PER JACKSON COUNTY REESTABLISHMENT BOOK PAGE 70
- ⊙ FD. BRASS CAP MONUMENT PER JACKSON COUNTY REESTABLISHMENT BOOK PAGE 95
- FD. BRASS CAP MONUMENT PER JACKSON COUNTY REESTABLISHMENT BOOK PAGE 5
- [] RECORD BEARING/DISTANCE PER RS 13013


BEARINGS BASED UPON FILED SURVEY NUMBER 13494

APPROVED BY JACKSON COUNTY PLANNING DEPARTMENT

Carol Parker
APPROVED BY

June 6, 1995
DATE

JACKSON COUNTY PLANNING DEPARTMENT FILE NO. 94_86_LLA

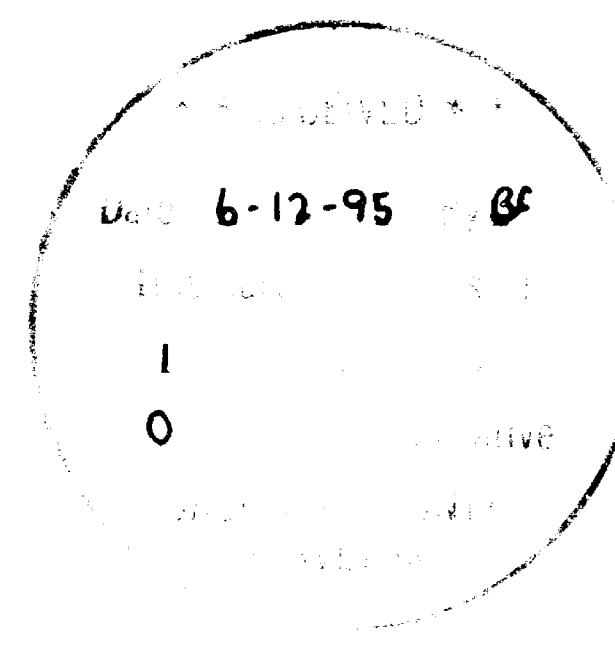

REGISTERED PROFESSIONAL LAND SURVEYOR
Richard C. Templin
OREGON
JULY 26, 1988
RICHARD C. TEMPLIN
2359
My Certificate Expires Dec. 31, 1994

RICHARD TEMPLIN LAND SURVEYING
100 POORMAN CR. RD. 899-2032 / 474-7720 JACKSONVILLE, OR. 97530
PROPERTY LINE ADJUSTMENT
LOCATED IN
GOVT. LOT 5, SECTION 11, T.36S., R.2W., WM.
JACKSON COUNTY, OREGON
SURVEYED FOR: MR. GEORGE NEVILLE 2438 NEVILLE LANE MEDFORD, OREGON 97501
DATE: June 5, 1995