

T37S R2W WM  
11 12  
14 13

ELK STREET

FD. 3/4" I. PIPE N. O. 49' W. O. 19'

N.W. CORNER  
D/R V438 P344

N.W. CORNER  
D/R V453 P280

S 89° 37' 00" E 316.19'

EAST 1050.41'

S 89° 37' 00" E 200.00' (REC. 89° 31' 00" E)

116.19'

N/L D/R V453 P280

NE. CORNER  
D/R V438 P344

TRACT TO BE ACQUIRED  
FROM LLOYD & K.S.  
NEILSON

ROBERTS MOTOR CO. INC.  
D/R V438 P344

S.W. CORNER  
D/R V438 P344


N 89° 37' 00" W 200.00' (REC. N 89° 31' 00" W)

N.W. CORNER  
D/R V453 P280

S.E. CORNER  
D/R V438 P344

N/L D/R  
V453 P280

● = SET 5/8" STEEL PIN  
BEARINGS FROM PREVIOUS  
SURVEY

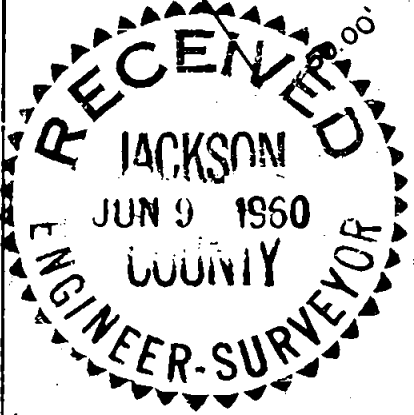

REGISTERED  
OREGON  
LAND SURVEYOR

*Leland P. Lovejoy*

NOVEMBER 18, 1949  
LELAND P. LOVEJOY  
262

BOUNDARY SURVEY  
SITUATED IN  
SECTION 14, T37S, R2W, W.M.  
MEDFORD, JACKSON COUNTY, OREGON  
FOR  
ROBERTS MOTOR COMPANY, INC.  
L.P. LOVEJOY, L.S. MEDFORD, OREGON  
SCALE: 1" = 60'  
JUNE 6, 1960

1457

1457

Survey Narrative to Comply with Section 87-3301947 Oregon State Laws

Survey For: Roberts Motor Co. Inc.  
Portland, Oregon

Purpose of Survey: To establish property boundaries.

Survey Location: Section 14, Township 37 South,  
Range 2 West, Willamette Meridian,  
Jackson County, Oregon.

Survey Procedure: Found section corner and North  
Pacific Highway right-of-way  
monuments. Ran out deed  
description and set 5/8" steel pins  
as shown on map.

Leland P. Lovejoy  
Registered Land Surveyor

Work completed June 6, 1960

