


14578

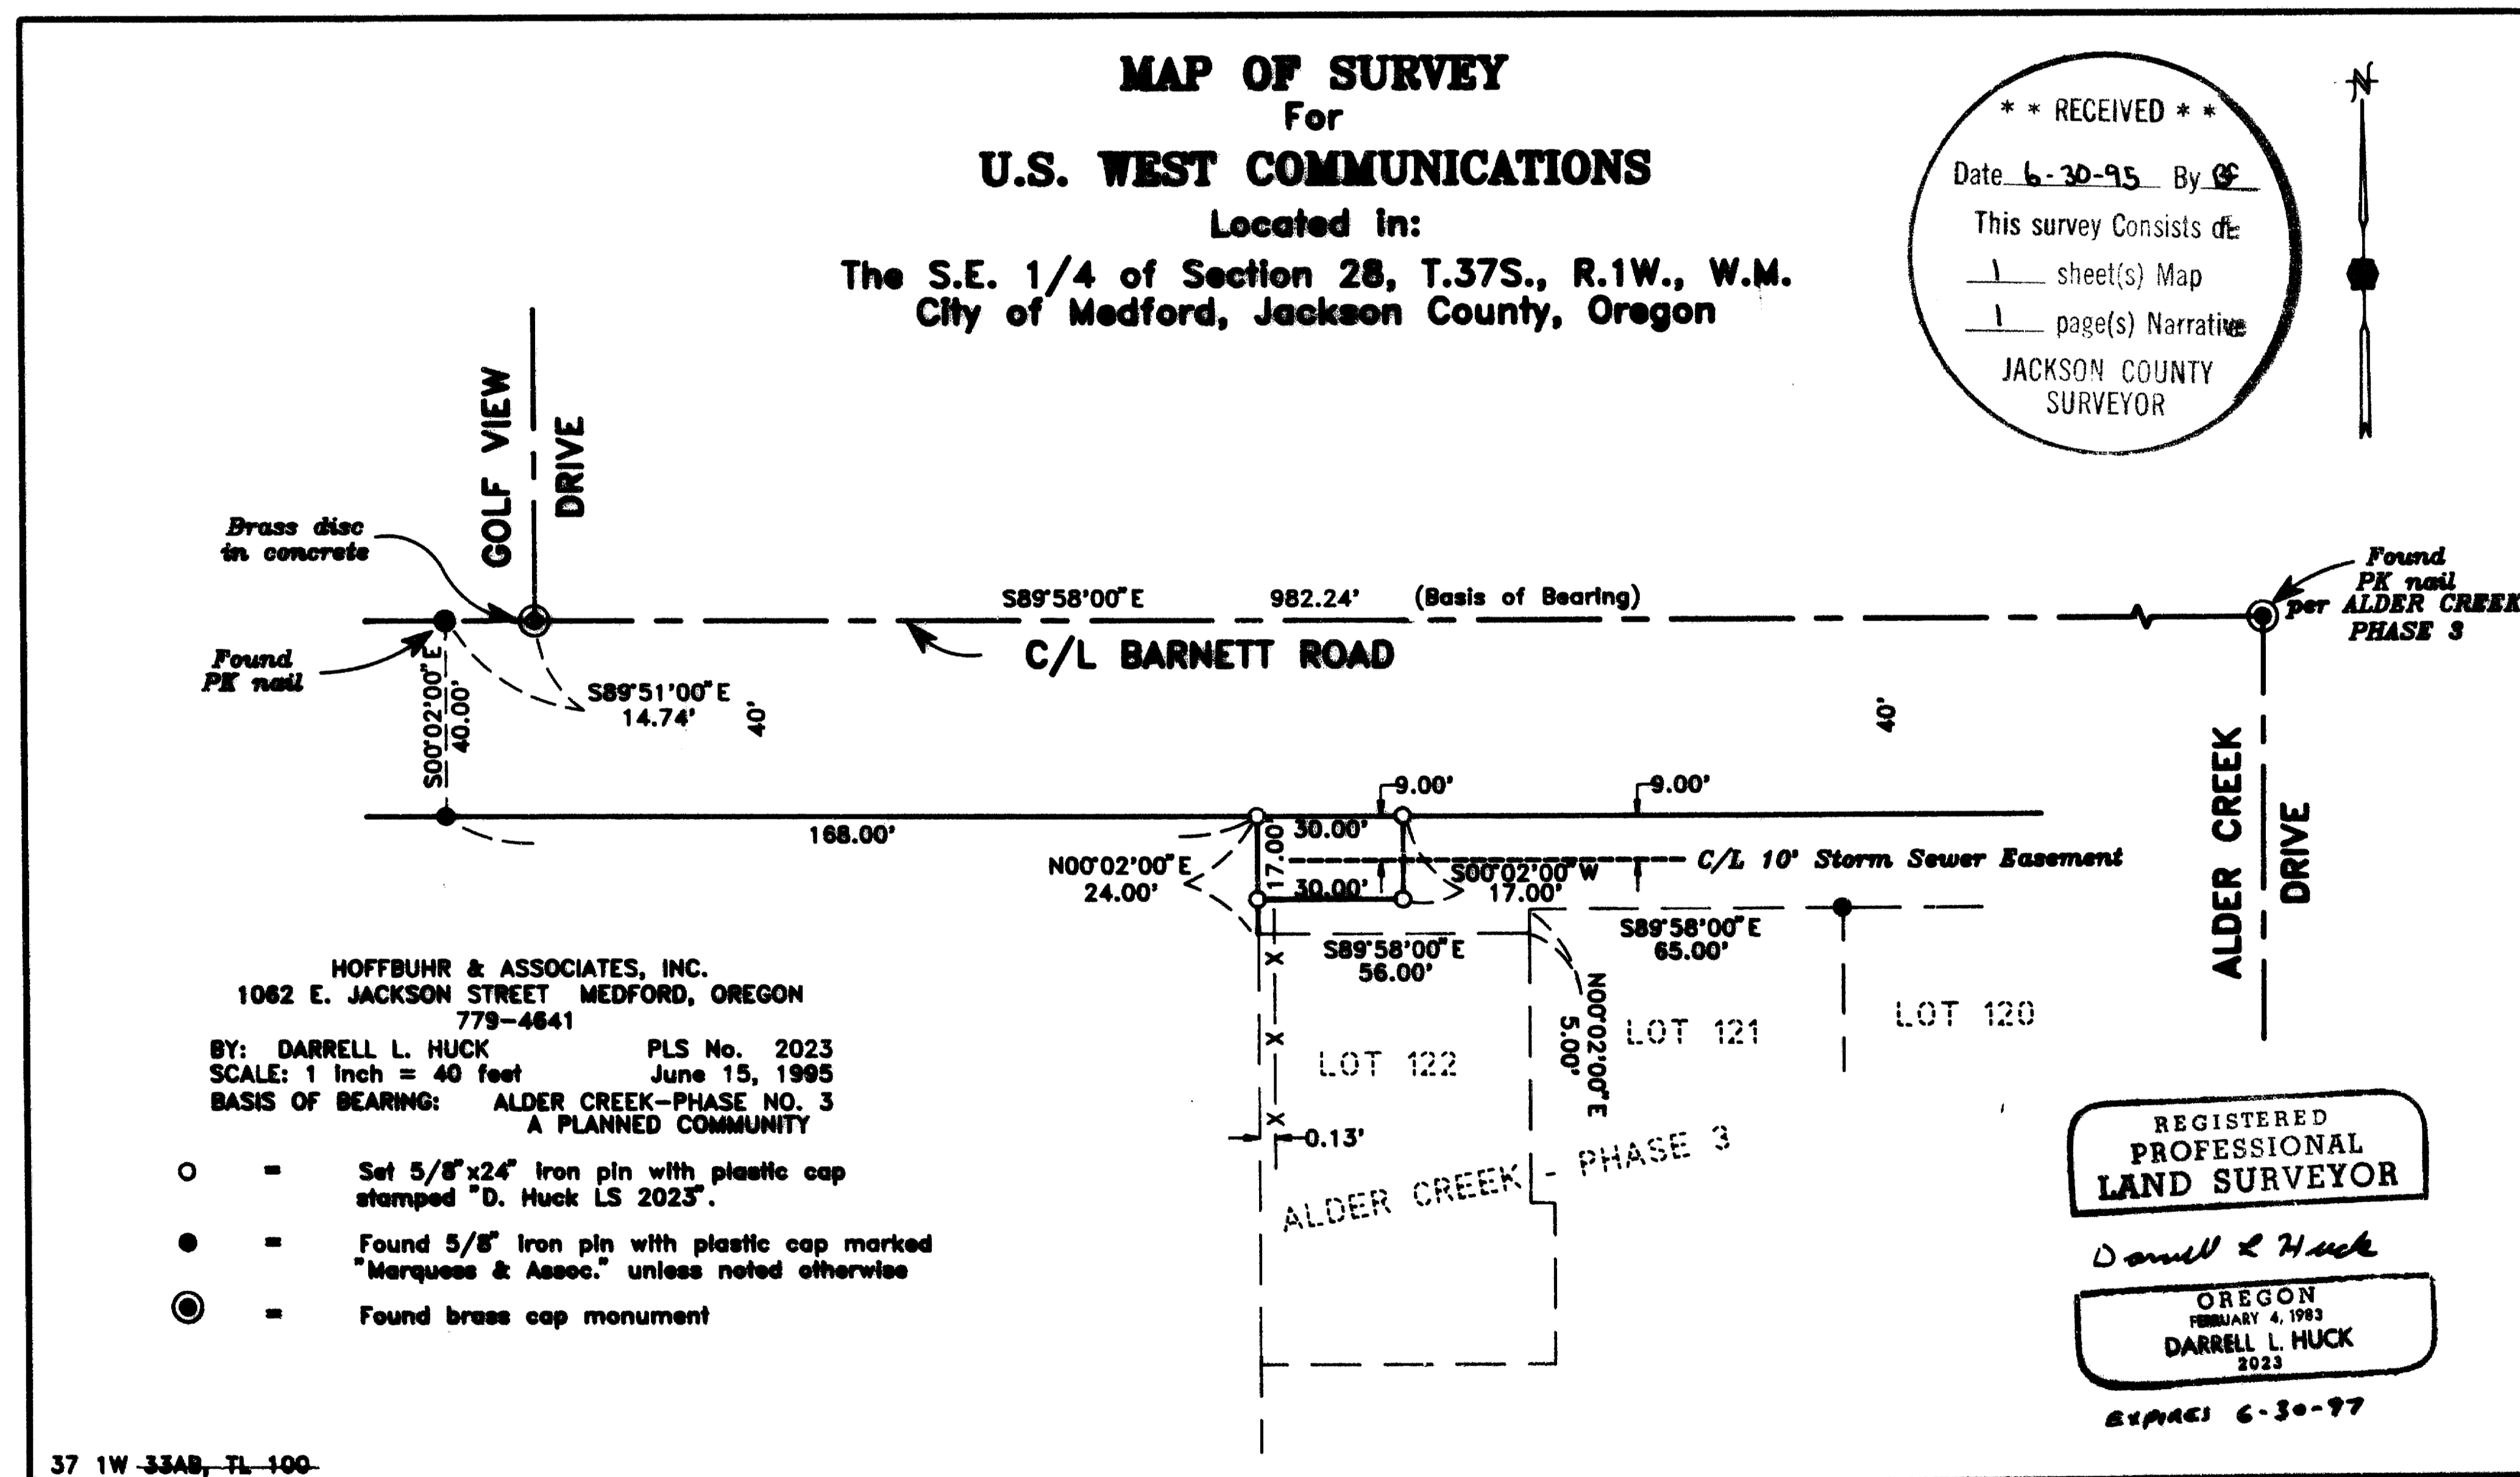

14578

SURVEY NO. 14578

**SURVEY NARRATIVE TO COMPLY WITH PARAGRAPH 209.250
OREGON REVISED STATUTES**

Survey for: U.S. West Communications
132 West 4th Street
Medford, Oregon 97501


Location: Southeast one-quarter (1/4) of Section 28 in Town-
ship 37 South, Range 1 West, Willamette Meridian,
City of Medford, Jackson County, Oregon

Purpose: To survey and monument an easement location as
directed by client

Procedure: Utilizing a one-second theodolite and electronic
distance measuring equipment, a control traverse
was run tying found monuments as shown on the
attached map. The location of the easement was
computed and monuments were set as per client's
direction.

Basis of
Bearing: Alder Creek - Phase No. 3 - A Planned Community

Date: June 15, 1995

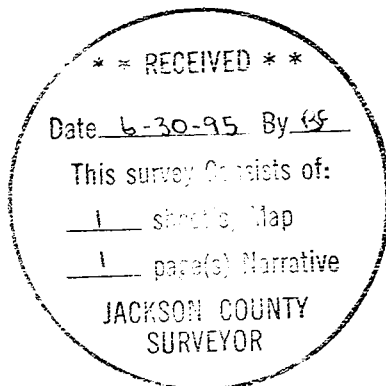

REGISTERED
PROFESSIONAL
LAND SURVEYOR

Darrell L. Huck

OREGON
FEBRUARY 4, 1983
DARRELL L. HUCK
2023

Darrell L. Huck
L.S. 2023 - Oregon
Expires 6/30/97
Hoffbuhr & Associates, Inc.