

Edwards Surveying & Land Planning Inc.

816 West 8th Street
Medford, OR 97501
Tel.: (503) 776-2313
FAX: (503) 776-9978



598 NE "E" Street, Suite B
Grants Pass, OR 97526
Tel.: (503) 471-7059
FAX: (503) 471-7809

SURVEYING • ENGINEERING • PLANNING

SURVEY NUMBER 14593

SURVEY NARRATIVE TO COMPLY WITH CHAPTER 209, PARAGRAPH 250, OREGON REVISED STATUTES

SURVEY FOR: Ashland Life Support
c/o Gordon Brown
287 Maple Street
Ashland, Oregon 97520

LOCATION: In the SE 1/4 of Section 5, T. 39 S.,
R. 1 E., W.M., City of Ashland, in Jackson
County, Oregon.



PURPOSE: To locate and monument the boundaries of tract
described in Vol. 484, Pg. 111, Deed Records
for Jackson County as shown on the accompanying
map.

PROCEDURE: Utilizing for control the found monuments and
deed reference as shown on the attached map,
computed the boundary positions. Monuments set
on this survey consist of 5/8" x 24" steel pins
with red plastic caps mkd. "D.A. EDWARDS-
LS 2339".

**BASIS OF
BEARINGS:** Survey Number 11196 as shown.

EQUIPMENT: Nikon DTM-A5 Electronic Total Station.

**DATE
COMPLETED:** May 26, 1995.

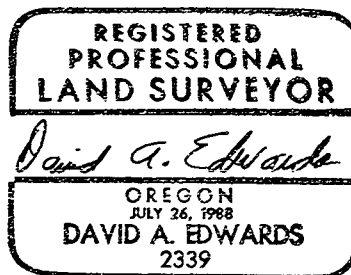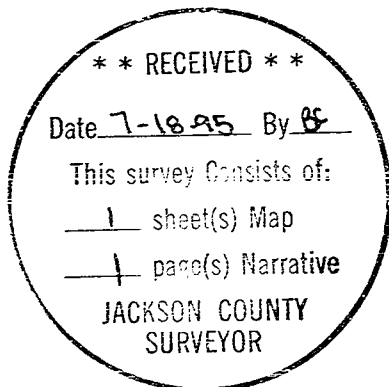

Expires 12/31/95