

14602

Survey For

Joseph F. & Jean E. Ira
1930 Bristol Drive
Medford, Oregon
97504

Location

SW 1/4 Section 10,
T.34S., R.1W., W.M.,
City of Shady Cove,
Jackson County, Oregon

Survey By



Kaiser Surveying
19440 Highway 62
Eagle Point, Oregon
97524

Date

July 10, 1995

Legend

- Found monument as indicated
 - Found 5/8" Rebar/Plastic Cap (S.N. 13283)
 - Set 5/8" x 24" Rebar with Plastic Cap marked "KAISER RLS 803"
- S.N. = Filed Survey Number
(Filed Surveyors Office)
- W.C. = Witness Corner

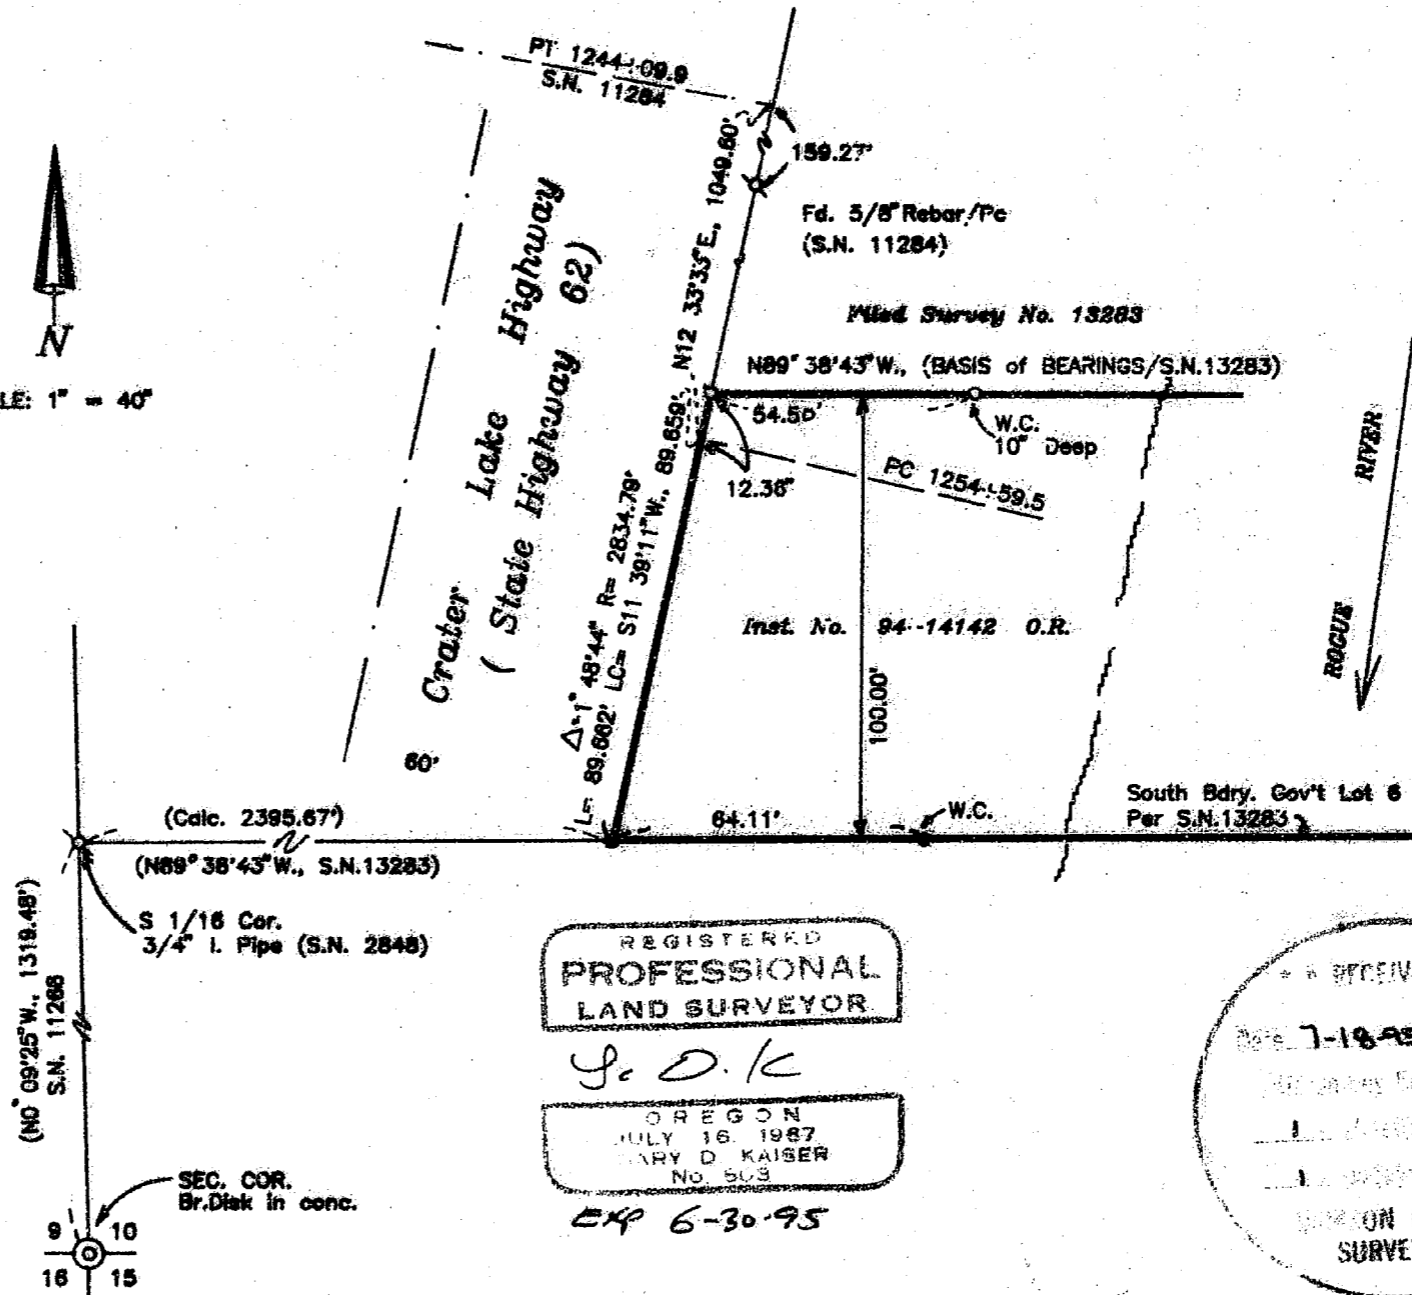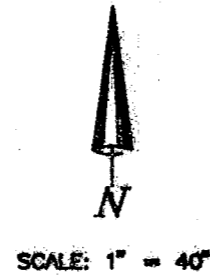

REGISTERED
PROFESSIONAL
LAND SURVEYOR

J. D. K.

OREGON
JULY 16, 1987

EXP 6-30-95

* * RECEIVED * *

Date 7-18-95 By GE




JACKSON COUNTY
SURVEYOR

14602

GARY D. KAISER
R.P.L.S. ORE. 803
C.W.R.E. ORE. 73

KAISER SURVEYING
19440 HIGHWAY 62
EAGLE POINT, OREGON 97524

PHONE
SHADY COVE (503) 878-3995
Fax (503) 878-3995

SURVEY NO. 14602

SURVEY NARRATIVE TO COMPLY WITH O.R.S. 209.250

SURVEY FOR: JOSEPH F. & JEAN E. IRA
1930 BRISTOL DRIVE
MEDFORD, OR 97504

SURVEY BY: KAISER SURVEYING
19440 HWY. 62
EAGLE POINT, OR 97524

LOCATION: SW ¼ of Section 10, T. 34 S.,
R. 1 W., W.M., City of Shady Cove,
Jackson County, Oregon




BASIS OF BEARINGS: Filed Survey No. 13283 (South Bdry.)

DATE: July 10, 1995

PURPOSE: Monument tract described in Inst.
No. 94-14142 O.R.

PROCEDURE: The subject tract boundaries were
monumented utilizing controls shown on Filed Survey No.
13283.

The highway 62 right-of-way lines were located per Filed
Survey No. 11284 and state highway right-of-way map County
Surveyors File No. 97/5.

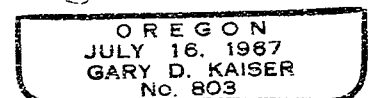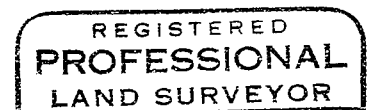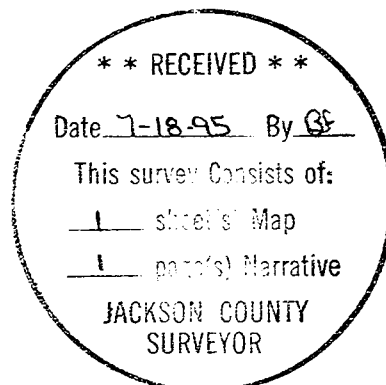

EXP 6-30-97