14603

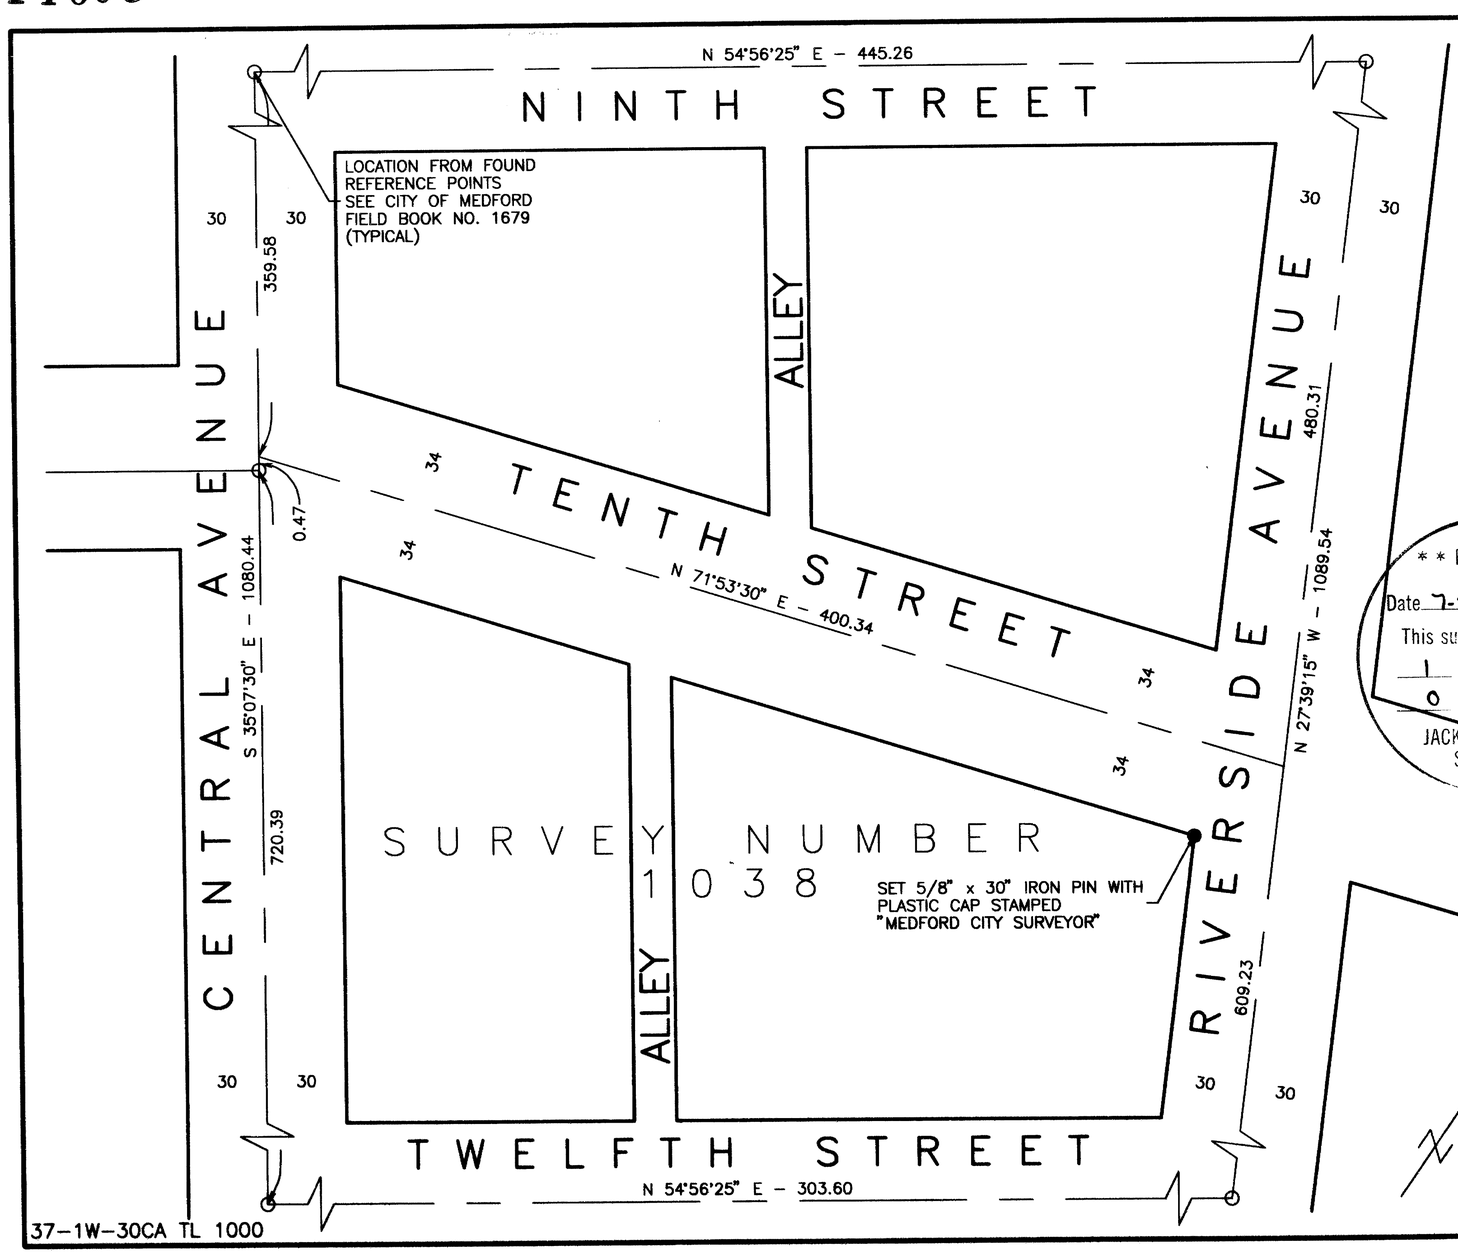

MAP OF SURVEY

LOCATED IN BROBACK'S RESERVE
CITY OF MEDFORD, JACKSON COUNTY
OREGON

SURVEY TO COMPLY WITH O.R.S. 290.250

FOR: CITY OF MEDFORD
411 WEST EIGHTH STREET
MEDFORD, OR 97501

DATE: JUNE 1995

PURPOSE: TO ESTABLISH THE SOUTHWEST CORNER OF TENTH STREET AND RIVERSIDE AVENUE.

PROCEDURE: UTILIZING THE REFERENCE POINTS SET FOR THE STREET CENTERS AS SHOWN (SEE CITY OF MEDFORD FIELD BOOK NO. 1679) AND THE LOCATION OF TENTH STREET AS ESTABLISHED ON FILED SURVEY NO. 1038 THE SOUTHWEST CORNER OF TENTH STREET AND RIVERSIDE AVENUE WAS COMPUTED TO BE AS SHOWN.

* * RECEIVED * *
Date 7-21-95 By BF
This survey consists of:
1 sheet(s) Map
0 page(s) Narrative
JACKSON COUNTY SURVEYOR

BASIS OF BEARING: CENTRAL AVENUE PER SURVEY NO. 1038

SURVEY BY: CITY OF MEDFORD
SURVEY DIVISION
411 WEST EIGHTH STREET
MEDFORD, OR 97501

SCALE: 1" = 50'

REGISTERED PROFESSIONAL LAND SURVEYOR
OREGON
JULY 14, 1978
PAUL D. LEWIS
1644

EXPIRES 12-31-96

14603