

NW COR.
D.L.C. # 56

1" = 30'

- SET 5/8"x30" REBAR WITH YELLOW PLASTIC CAP MARKED "TEMPLIN LS 2359"
 - ▲ FOUND 5/8"x30" REBAR WITH YELLOW PLASTIC CAP MARKED "TEMPLIN LS 2359" PER FILED SURVEY NUMBER I3929.
 - ⊕ FOUND JACKSON COUNTY BRASS CAP PER JACKSON COUNTY REESTABLISHMENT BOOK, PAGE 74
 - FOUND 1/2" IRON PIPE PER FILED SURVEY NUMBER 945
 - ⊙ FOUND 1/2" IRON PIPE PER FILED SURVEY NUMBER 448
 - FOUND OREGON STATE HIGHWAY ALUMINUM CAP MONUMENT.
 - △ CALCULATED POSITION
 - DR. RECORD BEARING/DISTANCE PER DEED RECORD.
- BEARINGS BASED UPON FILED SURVEY NUMBER I3929. AS SHOWN.
SURVEY NARRATIVE IS A SEPERATE DOCUMENT.

CURVE DATA

①	②	③	④
R - 159.15	R - 195.15	R - 145.36	R - 29.54
Δ - 37°52'25"	Δ - 37°52'25"	Δ - 10°07'40"	Δ - 89°44'14"
L - 105.20	L - 129.00	L - 26.69	L - 46.27
LC BRG - S 52°54'51" E	LC BRG - S 52°54'51" E	LC BRG - N 29°45'42" W	LC BRG - N 9°42'04" E
LC - 103.30	LC - 126.66	LC - 25.66	LC - 41.68

37-2W-2CD TL'S 2500,2900,3000,3100

RECEIVED
Date 8-14-95 by [Signature]
THIS SURVEY WAS MADE BY [Signature]
I AM A LICENSED SURVEYOR
JACKSON COUNTY SURVEYOR

REGISTERED
PROFESSIONAL
LAND SURVEYOR
[Signature]
RICHARD G. TEMPLIN
2359
My Certificate Expires Dec. 31, 1996

RICHARD TEMPLIN LAND SURVEYING
100 POORMAN CREEK RD. 999-2082 / 474-7720 JACKSONVILLE, OREGON

MAP OF SURVEY
LOCATED IN
THE SE 1/4 OF THE SW 1/4 OF SECTION 2, T.37S., R.2W., W.M.
JACKSON COUNTY, OREGON

SURVEYED FOR: Maciellan & Assoc.
2660 Bullock Rd.
Medford, Or. 97501

DATE: July 19, 1995

RICHARD G. TEMPLIN
PROFESSIONAL LAND SURVEYOR
100 Poorman Creek Road
Jacksonville, Oregon 97530
Phone/Fax: (503) 899-2032 • 474-7720

NARRATIVE

Survey No. 14684

SURVEY FOR: Maclellan and Assoc.
2666 Bullock Rd.
Medford, Oregon 97504


LOCATION: The SE 1/4 of the SW 1/4 of Section 2, Township
37 South, Range 2 West, of the Willamette
Meridian, Jackson County, Oregon.

PURPOSE: To survey and monument the deed corners of the
parcels shown on the accompanying map, per my
clients request.

DATE: July 19, 1995

BASIS OF: Bearings based upon Recorded Survey number 13929,
as shown on accompanying map.

PROCEDURE: Tied monuments set on Recorded Survey number 940
and Oregon State Highway monuments set for the
right of way of the re-located Freeman Road
project and the relocated Ninth Street project.
The permanent easement shown on the accompanying
map was scaled from the Oregon State Highway map
and is an approximate location only. Computed
and set monuments, as shown.

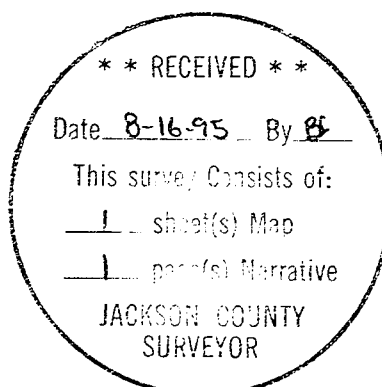

REGISTERED
PROFESSIONAL
LAND SURVEYOR

RT
OREGON
JULY 26, 1988
RICHARD G. TEMPLIN
2359

My Certificate Expires Dec. 31, 19 76