

MAP OF SURVEY

LOCATED in the W 1/2 of Section 15,
T. 39 S., R. 1 W., W.M.,
Jackson County, Oregon

August 18, 1995

14637

9 | 10
16 | 15
Fd. 1972 B.L.M.
Brass Cap

SURVEYED FOR: *Medite Corp.*
P.O. Box 550
Medford, Oregon 97501

SURVEYED BY: *Edwards Surveying and Land Planning Inc.*
816 West 8th Street
Medford, Oregon 97501
Phone: (503) 776-2313

(2640.0')
2718.08'

Area of
Encroachment

5436.16'
(5280.0')

1/4 Corner
See Narrative

North

(2640.0')
2718.08'

16 | 15
21 | 22
Fd. 1972 B.L.M.
Brass Cap

REGISTERED
PROFESSIONAL
LAND SURVEYOR

David A. Edwards

OREGON
JULY 24, 1988
DAVID A. EDWARDS
2339

Expires 12/31/95



SCALE: 1" = 600'

** RECEIVED **

Date: 8/22/95 By: SK

This survey consists of:

1 sheet(s) Map

1 page(s) Narrative

JACKSON COUNTY
SURVEYOR

LEGEND

o Indicates a 5/8" X 30" steel pin w/ red plastic cap mhd. 'D.A. EDWARDS--LS 2339' set.

() Denotes record data per G.L.O.

BASIS OF BEARINGS: G.L.O. record North on Section line.

14637

Edwards Surveying & Land Planning Inc.

816 West 8th Street
Medford, OR 97501
Tel.: (503) 776-2313
FAX: (503) 776-9978



598 NE "E" Street, Suite B
Grants Pass, OR 97526
Tel.: (503) 471-7059
FAX: (503) 471-7809

SURVEYING • ENGINEERING • PLANNING

SURVEY NUMBER 14637

SURVEY NARRATIVE TO COMPLY WITH CHAPTER 209, PARAGRAPH 250,
OREGON REVISED STATUTES

SURVEY FOR: MEDITE Corporation
P.O. Box 550
Medford, Oregon 97501

LOCATION: In Section 15, T. 39 S., R. 1 W., W.M.,
Jackson County, Oregon.

PURPOSE: To locate and monument the westerly boundary of
MEDITE land in Section 15 and to blaze trees
marking the boundaries of said lands as shown on
the accompanying map.


PROCEDURE: Control traverses were run to tie in the
controlling Government corners as shown. After a
search revealed no evidence of the original corner,
the proportioned position of the West 1/4 of Section
15 was then computed. The true lines were then
marked and trees were blazed if they were within 3
feet of the line. Bearing trees were marked
according to the 1973 B.L.M. Manual and were
measured to the center of the tree at the root
crown. Monuments set on this survey consist of
5/8" x 3/8" steel pins with red plastic caps mkd.
"D.A. EDWARDS-LS 2339". The bearing objects
and trees are situated as follows:

At the 1/4 corner of Sections 16 and 15:
A 9" diam. Pine brs. S. 53° E., 28.0 feet.
A 18" X 12" X 3/8" exposed bedrock outcrop
with chisled 'X' brs. S. 18° W., 4.3 feet.
A 20" X 16" X 18" exposed bedrock outcrop
with chisled 'X' brs. N. 60° E., 32.4 feet.
A 24" X 12" X 16" exposed bedrock outcrop
with chisled 'X' brs. N. 15° E., 14.2 feet.

BASIS OF
BEARINGS: G.L.O. record North on Section line.

EQUIPMENT: Nikon DTM-A5 Electronic Total Station.

DATE
COMPLETED: August 18, 1995

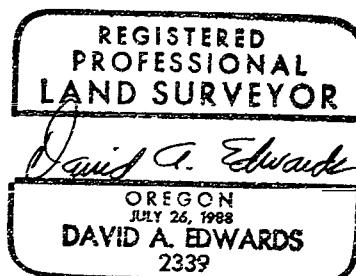

Expires 12/31/95

