

REGISTERED  
**OREGON**  
 LAND SURVEYOR

*Leland P. Lovejoy*

NOVEMBER 18, 1949  
 LELAND P. LOVEJOY  
 262

BEARINGS BY SOLAR OBSERVATION


● = SET 5/8" STEEL PIN

BOUNDARY SURVEY  
 SITUATE IN

D.L.C. NO. 60, T37S R2W W.M.  
 JACKSON COUNTY, OREGON

FOR

STANDARD OIL CO. OF CALIFORNIA  
 L.P. LOVEJOY L.S. MEDFORD, ORE.  
 SCALE 1" = 100' APRIL 5, 1960

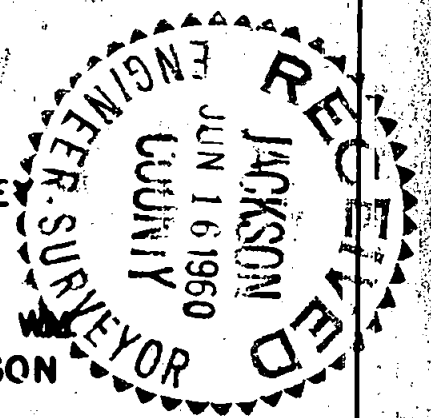

1464

1464

Survey Narrative to Comply with Section 87-3301947 Oregon State Laws

Survey For: Standard Oil Co. of California  
San Francisco, California

Purpose of Survey: To establish property boundaries.

Survey Location: D. L. C. 60, Township 37 South,  
Range 2 West, Willamette Meridian,  
Jackson County, Oregon (within  
City Limits of Medford, Oregon).

Survey Procedure: Found D. L. C. corners and other  
survey monuments and used this for  
basis of survey control. Set 5/8"  
steel pins as shown on map.

Leland P. Lovejoy  
Registered Land Surveyor  
Work completed April 5, 1960

