

POSITION OF STREET INTERSECTION
DETERMINED FROM REFERENCES OBTAINED
FROM CITY OF ASHLAND, OREGON

FD. 1-1/8" x 1-1/8" I. PIN
0.6' BELOW SURFACE ASPH.
CONC. PAVEMENT.


347.28' (CITY REC. 347.20')
E IOWA STREET

22.22'
SET SPIKE

ALLEDALE ADDITION

E PALM AVENUE

SET SPIKE

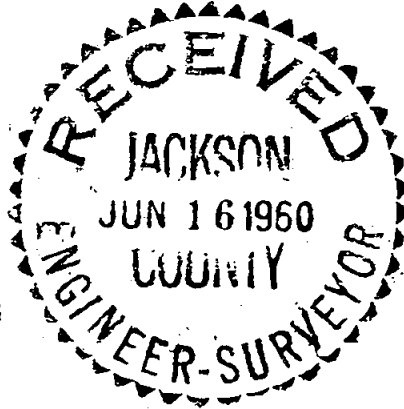

WLY R/W LINE GARFIELD STREET

S 0°04'00" W

ON GARFIELD STREET

ADDITION

BUNGALOW



22.22'

S/L VOL. 252, P. 530

(REC. EAST 130.00')

S 89°56'00" E 130.00'

FD. 1" I. PIPE
0.17N.

(REC. NORTH 88.15')
N 0°04'00" E 88.25'

FD. 3/4" I. PIPE
0.58S. & 0.04W.

NLY R/W LINE
E SISKIYOU BLVD.
S'LY R/W LINE

(REC. 156.40')
N 56°13'00" W 156.29'

REC. N 56°13'00" W

S 0°04'00" W 175.00'
(REC. NORTH)

SET SPIKE

● = SET 3/4" G.I. PIPE
W/LEAD PLUG &
COPPER TACK

BEARINGS FROM
PREVIOUS SURVEY

BOUNDARY SURVEY
SITUATED IN
ASHLAND,
JACKSON COUNTY, OREGON
FOR

DOUGLAS OIL CO. OF CALIFORNIA
L.P. LOVEJOY, L.S. MEDFORD, ORE
SCALE: 1" = 100' MAY 17, 1960

REGISTERED
OREGON
LAND SURVEYOR

Leland P. Lovejoy

NOVEMBER 18, 1949
LELAND P. LOVEJOY
262

30.00' 50.00'

Survey Narrative to Comply with Section 87-3301947 Oregon State Laws

Survey For: Douglas Oil Co. of California
Paramount, California

Purpose of Survey: To establish property boundaries

Survey Location: Corner of Siskiyou Boulevard and
Garfield Street, Ashland, Oregon

Survey Procedure: Found survey monuments as shown
on map and used for basis of survey
control. Set 3/4" G.I. pipe with lead
plugs and copper tacks.

Leland P. Lovejoy
Registered Land Surveyor
Work completed May 17, 1960

