

MAP OF SURVEY

PREPARED FOR: **WYATT & TODD ROSBOROUGH**

339 1/2 Oak Grove Road
Medford, Oregon 97501

Located in the Southwest One-quarter of Section 26,
Township 37 South, Range 2 West, Willamette Meridian
Jackson County, Oregon

SURVEY NARRATIVE

PURPOSE: Survey and monument the Rosborough property.


PROCEDURE: A closed control traverse was performed encompassing the found monuments shown hereon. Based on said control survey, recorded deeds and plats provided by Clients and/or their agents and research of Official Record of Jackson County, established Clients property as depicted hereon.

NOTES

Vol. & Pg. = Deed records for Jackson County, Oregon
Doc. No. = Official records for Jackson County, Oregon
S.N. = Survey Number
(M) = Measurement performed this survey
(R) = Record Information

LEGEND

- ⊙ Indicates found brass cap monument as described
- Indicates found monument as described
- Indicates set 5/8" x 24" steel pin with yellow plastic cap marked "NEATHAMER-LS 2675"
- () Indicates record data per S.N. 9080.
- [] Indicates record data per Vol. 363, Pg. 341
- { } Indicates record data per Doc. No. 93-33648

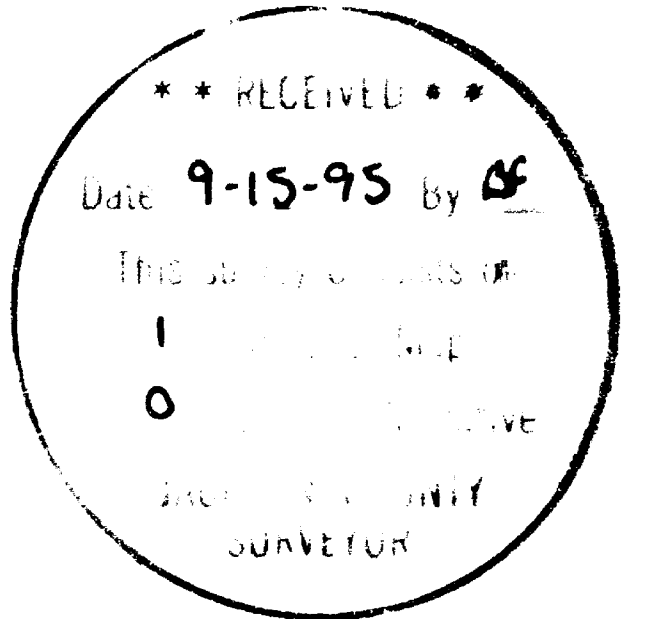

SURVEYED BY: **BOB NEATHAMER**
2074 HILL WAY
MEDFORD, OREGON 97504
(503) 779-9310

COMPUTED & DRAFTED BY: **RYN**
SCALE: 1 inch : 50 feet
DATE: 13 AUG 1995

Found Brass Cap +/- 0.4'
below ground surface
stamped: "T375 R2W SW 75 D.L.C."