

MAP OF SURVEY

LOCATED IN THE S.E. 1/4 OF SECTION 36
T. 37 S., R. 2 W., W.M., JACKSON COUNTY, OREGON
NOVEMBER 6, 1995

FD. BRASS DISC IN MON. CASE
N.E. COR. DLC # 82

☉ GARFIELD ST.

FD. PIN & CAP S.N. 10414
KAISER RLS 803

BLOCK NO. 1
OAKDALE PARK ADDITION

** RECEIVED **
Date 11-13-95 By ☉
This survey consists of:
1 sheet(s) Map
1 page(s) Narrative
JACKSON COUNTY
SURVEYOR

SET 5/8" X 30" PIN W/
JACKSON CO. PUBLIC WORKS CAP

PROSPECT ST.
(VACATED)

REGISTERED
PROFESSIONAL
LAND SURVEYOR

James P. Dickerson

OREGON
JANUARY 17, 1995
JAMES P. DICKERSON

EXPIRES 12-31-95

Jackson County Roads
and Parks Services
200 Antelope Road
White City, Oregon 97503

T37S-R2W-36DD T.L. 100



SCALE: 1" = 100'

FD. 5/8" REBAR

☉ DIAMOND ST.

356.21' S.N. 10414 (REC 356.00')
20'
1188.63' (REC 1188.00')
S 0° 06' 30" W
S.N. 10414
BASIS OF BEARING
KINGS HWY.

14744

14744

SURVEY NO. 14744

SURVEY NARRATIVE TO COMPLY WITH O.R.S. 209.250

SURVEY FOR: Jackson County Roads and Parks Services
200 Antelope Road
White City, Oregon



LOCATION: S.E. 1/4 Section 36 T. 37 S., R. 2 W., W.M.,
Jackson County, Oregon.

PURPOSE: To re-establish the S.E. corner monument of Block #1,
Oakdale Park Addition as set by R.S. 10414. The monument
was destroyed during roadside maintenance activity.

PROCEDURE: Utilizing a Wild TC1010 total station, monuments were
found and tied as shown. The tract corner was
re-established using the data from S.N. 10414.

SURVEY BY: Jackson County Roads and Parks Services
James P. Dickerson L.S., Survey Chief
200 Antelope Road
White City, Oregon

DATE: November 6, 1995

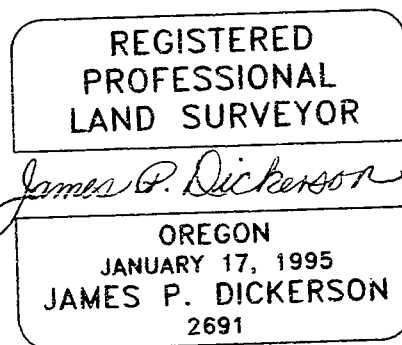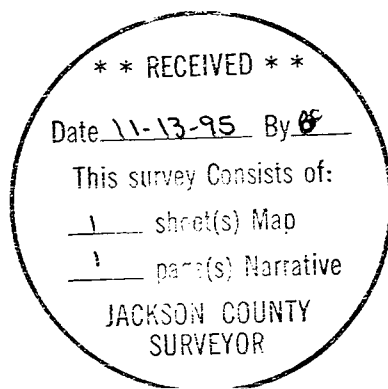

EXPIRES 12-31-95

Jackson County Roads
and Parks Services
200 Antelope Road
White City, Oregon 97503