

Edwards Surveying & Land Planning Inc.

816 West 8th Street
Medford, OR 97501
Tel.: (503) 776-2313
FAX: (503) 776-9978



598 NE "E" Street, Suite B
Grants Pass, OR 97526
Tel.: (503) 471-7059
FAX: (503) 471-7809

SURVEYING • ENGINEERING • PLANNING

SURVEY NUMBER 14776

SURVEY NARRATIVE TO COMPLY WITH CHAPTER 209, PARAGRAPH 250, OREGON REVISED STATUTES

SURVEY FOR: France Development Company, Inc.
c/o Nancy France
6101 Dark Hollow Road
Medford, Oregon 97501

LOCATION: In the SE 1/4 of Section 22, T. 37 S.,
R. 1 W., W.M., City of Medford, Jackson County,
Oregon.


PURPOSE: To locate and monument the boundaries of tax
lot 100 as shown on the accompanying map. This
property had an approval for a subdivision and
lot corner pins were set around the outside
boundary. The subdivision is now being
redesigned however.

PROCEDURE: Utilizing for control the found monuments as
shown, computed the boundary as shown. The
center line monuments in Hillcrest Road were
held for alignment of that right of way.
Monuments set on this survey consist of 5/8" x
30" steel pins with red plastic caps mkd.
"D.A. EDWARDS-LS 2339".

BASIS OF
BEARINGS: Survey Number 1156.

EQUIPMENT: Nikon DTM-A5 Electronic Total Station.

DATE
COMPLETED: November 21, 1995.

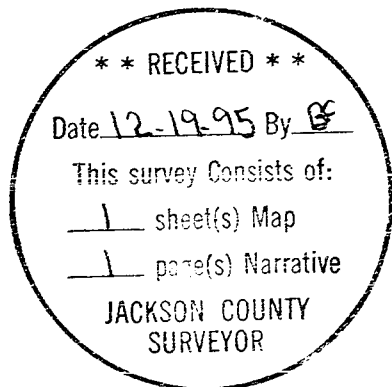

Expires 12/31/97