


NARRATIVE:

SURVEY TO ESTABLISH AND FLAG THE NORTHERLY 30 AC. OF THE N.W. 1/4 OF SECTION 30 AS SHOWN AND DESCRIBED PER DEED VOLUME 342, PAGE 426 (INST. NO. 296364) IN THE RECORDS OF JACKSON COUNTY, OREGON. THE N.W. 1/4 OF SAID SECTION WAS ESTABLISHED BY TYING THE SECTION CORNER & 1/4 CORNERS AS SHOWN HEREON, BY USING G.P.S. RECEIVERS AND CONVENTIONAL SURVEY METHODS COMBINED. BASIS OF BEARING PER G.P.S. OBSERVATION AND ROTATED FROM GRID TO TRUE - (MEAN θ ANGLE = P3711').

FIELD CREW: NEIL HIBBS, DAN SHEPHERD, & ROD McALLISTER
 EQUIPMENT: TRIMBLE 4000ST GPS RECEIVERS BAKKON TOTAL STATION
 OFFICE: ROMNEY WARE
 DRAFTING: TIM ADAMS

LEGEND:

- SET 1/4" x 30" IRON ROD w/ CAP MKD "I.E. ENG."
- FD MONUMENT AS NOTED
- △ COMPUTED POINT

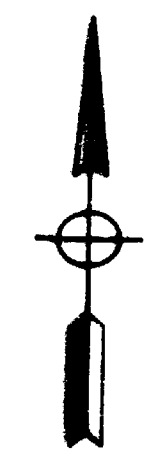

1-11-96 8F

1
0

REGISTERED OREGON LAND SURVEYOR		SURVEY IN THE N.W. 1/4 OF SEC. 30, T32S, R1W, W.M., JACKSON COUNTY, OREGON	
JULY 12, 1968 DONALD A. BENTZ 839		SURVEYED FOR: DICK HANLIN 18478 DIXONVILLE RD. ROSEBURG, OREGON 97470	
EXPIRES 12-31-95		SURVEYED BY: i.e. ENGINEERING	
SCALE: 1" = 400'		548 S.E. Jackson Suite 3 Roseburg, Oregon 97470 PHONE (503) 673-0166 FAX (503) 446-9392	
DATE: NOV. 1995		1126-01	
PAGE: 1 OF 1			