


- LEGEND**
- SET 5/8"x30" REBAR WITH YELLOW PLASTIC CAP MARKED "TEMPLIN LS 2359"
  - FOUND 5/8" IRON ROD PER FILED SURVEY NUMBER 776
  - ⊕ FOUND JACKSON COUNTY BRASS CAP PER JACKSON COUNTY REESTABLISHMENT BOOK, PAGE 16
  - ⊞ FOUND JACKSON COUNTY BRASS CAP PER JACKSON COUNTY REESTABLISHMENT BOOK, PAGE 20
  - △ CALCULATED POSITION
  - ( ) RECORD BEARING/DISTANCE PER FILED SURVEY NUMBER 776

**SURVEY NARRATIVE**

**PURPOSE:** To reestablish the deed corners of my clients property, per filed survey number 776.

**PROCEDURE:** My clients property was surveyed in 1955 for Standard Oil Co. of California, by L.N. Dow, survey number 776. To reestablish points set on said survey, a thorough search for pins found and set on filed survey number 776 was made. I found the SE and SW corners in good condition. The NW corner was found badly bent. I replaced it with a 5/8"x 30" rebar, as shown. The NE corner and angle point on the East line have been destroyed by underground work over the years. I reestablished these points as shown on the map. The O.S.H.D. r/w pin at Sta. 2099+46.88 has been destroyed. Ties to the NE corner of Section 30 and the E 1/4 of said Section 30, are as shown.

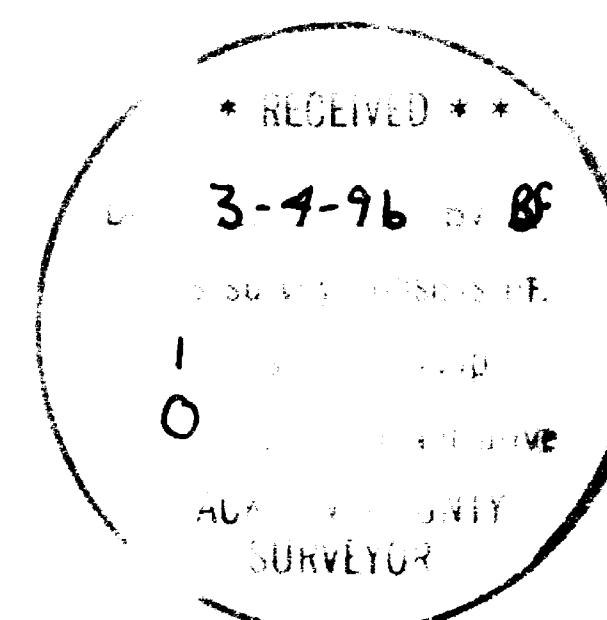

**REGISTERED PROFESSIONAL LAND SURVEYOR**  
*Richard G. Templin*  
 OREGON  
 JULY 14, 1994  
**RICHARD G. TEMPLIN**  
 2329  
 My Certificate Expires Dec. 31, 2004

**RICHARD TEMPLIN LAND SURVEYING**  
 100 FORDMAN CREEK RD. 899-2002 / 474-7720 JACKSONVILLE, OREGON

**DEPENDENT RESURVEY**  
 LOCATED IN  
 THE NE 1/4 OF SECTION 30, T.36S.,R.1W., W.M., JACKSON COUNTY, OREGON

SURVEYED FOR COLVIN OIL CO. DATE: FEBRUARY 5, 1996  
 2520 FOOTHILL BLVD.