

1487
 Fd. sandstone with cross
 N.W. cor. J.C.D.R. Vol. 8, Pgs. 428.

Survey For
 ERNEST L. WALZ
 Located in D.L.C. No. 97, Secs. 34 8 35
 T. 37 S. R. 2 W. 8
 D.L.C. No. 42, Secs. 2 8 3, T. 38 S. R. 2 W.
 By: Mark E. Boyden July 1958

1407

N 89° 55' 40" W 1262.8'

1728.9' N 0° 13' 20" W
 1728.9'

1068.94'
 S 89° 55' 40" E

ROAD

SOUTH


STAGE

Fd. sandstone with cross
 S.W. cor. J.C.D.R.
 Vol. 8, Pgs. 428.

R/D. CANAL R/W 50'

N.W. cor. D.L.C. No. 46, T. 38 S. R. 2 W.
 Fd. 1-1/2" Iron pipe

S.E. cor. D.L.C. No. 41
 Fd. sandstone with cross

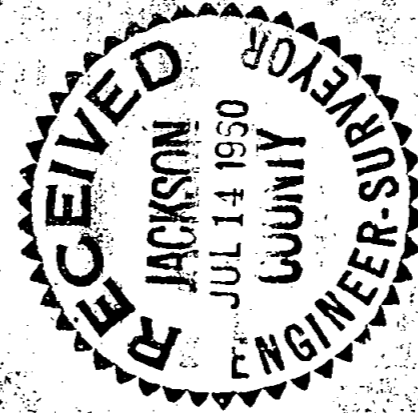

REGISTERED
 OREGON
 LAND SURVEYOR
 NOVEMBER 9, 1951
 MARK E. BOYDEN
 281

Scale: 1" = 100'
 Meridian by Solar Observation

Re-estab. Cert. corner
 Set iron pipe



1487

Survey Narrative to comply with Paragraph 209.250
Oregon Revised Statutes

FOR: E. L. Walz

PURPOSE: To monument and describe a 50 acre parcel in the Southwest corner of the Walz ownership located in D.L.C. No. 42, Sections 2 and 3, Township 38 South, Range 2 West and in D.L.C. No. 97, Sections 34 and 35, Township 37 South, Range 2 West.

PROCEDURE: Found sandstone monuments with cross on top at the Northwest and Southwest corners of the Walz property (See Jackson County Deed Records Volume 8, Page 428). Also found the re-established Northwest corner of D.L.C. #45 and the Southeast corner of D.L.C. #41, Township 38 South, Range 2 West to control the South property boundary (being also the North right-of-way line of Stage Road South). From the above control boundaries, monumented the North and East boundaries as directed by the owner.

Monumented the parcel with iron pipes as shown, with a meridian control by solar observation.

July 1958

REGISTERED
OREGON
LAND SURVEYOR
Mark E. Boyden
NOVEMBER 9, 1951
MARK E. BOYDEN
281

RECEIVED
JACKSON
JUL 14 1960
COUNTY
ENGINEER-SURVEYOR