


LEGEND


- ✝ SECTION CORNERS FOUND
- ⊘ 1/4 SECTION CORNERS FOUND
- ⊘ 1/4 SECTION CORNERS NOT FOUND
- SET PIPE FOR 1/4 CORNERS

BEARINGS BY SOLAR OBSERVATION

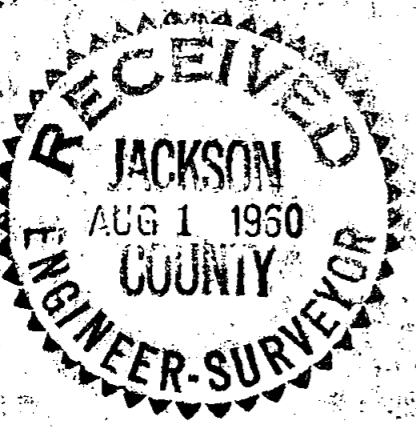

SURVEY FOR
 FIR MILLING AND PLANING CO.
 SITUATED IN
 SECTION 26, T40S, R2E, W.M.
 JACKSON COUNTY, OREGON

L.P. LOVEJOY, REGISTERED LAND SURVEYOR
 MEDFORD, OREGON JULY 14, 1960
 SCALE: 1" = 600'

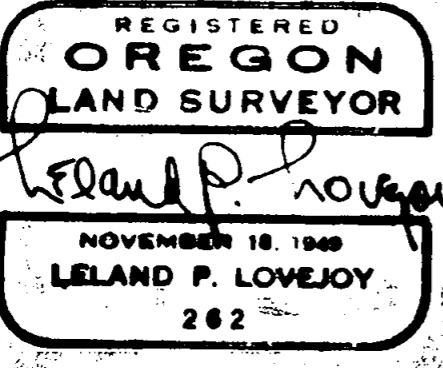

Survey Narrative to Comply with Section 87-3301947 Oregon State Laws

Survey for: Fir Milling & Planing Co.
505 Tolman Creek Road
Ashland, Oregon

Purpose of Survey: To determine property boundaries.

Survey Location: Section 26, Township 40 South,
Range 2 East, Willamette Meridian,
Jackson County, Oregon.

Survey Procedure: Found re-established section and
quarter corners, also original bearing
trees, as shown on map, and, from
original field notes, set 2" iron pipe
to perpetuate the quarter corner between
Section 23 and 26 and section corner
common to Sections 23, 24, 25 and 26.
Re-established quarter corner between
Sections 25 and 26 at mid-point between
section corners. Established 1/16
corners and set 1 3/4" and 2" iron and
steel pipes as shown.

Leland P. Lovejoy
Registered Land Surveyor
Work completed July 21, 1960

